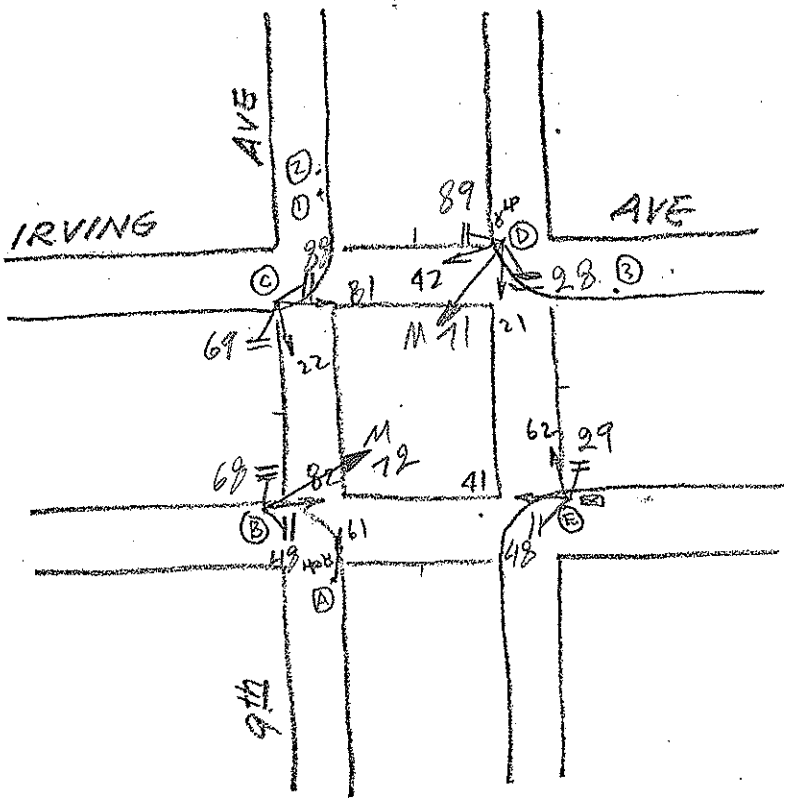

Φ2

5/23/08
3-1-79

POLE	FUNC.	MAT'L
A	S	C
B	S	C
C	M	C
D	S	C
E	S	C
1	U	W
2	M	S
3	M	S

SIGNAL NO.	MAKE	NO. OF SECT.	SIZE	VISOR	B.P. OR LOUVERS	MOUN'T
61	GA	3	8"	FC 8"	No	T
82	GA	3	8"	FC 8"	No	T
22	GA	3	8"	FC 8"	No	S
81	GA	3	8"	FC 8"	No	S
42	GA	3	8"	FC 8"	No	T
21	GA	3	8"	FC 8"	No	T
62	GA	3	8"	FC 8"	No	T
41	GA	3	8"	FC 8"	No	T
71	TCT	2	12"	FC 12"	NO	T
72	TCT	2	12"	FC 12"	NO	T

PED SIGNAL NO.	LEGEND	MESSAGE ELEMENT	MESSAGE COLOR	MAKE	MOUN'
28	I	15-C	W/R		S
29	I	15-C	W/R		S
48	I	15-C	W/R		S
49	I	15-C	W/R		S
68	I	15-C	W/R		S
69	I	15-C	W/R		S
88	I	15-C	W/R		S
89	I	15-C	W/R		S

CONTROLLER CABINET SIZE : ORDINARY BASE CABINET: NO

COMMENTS :