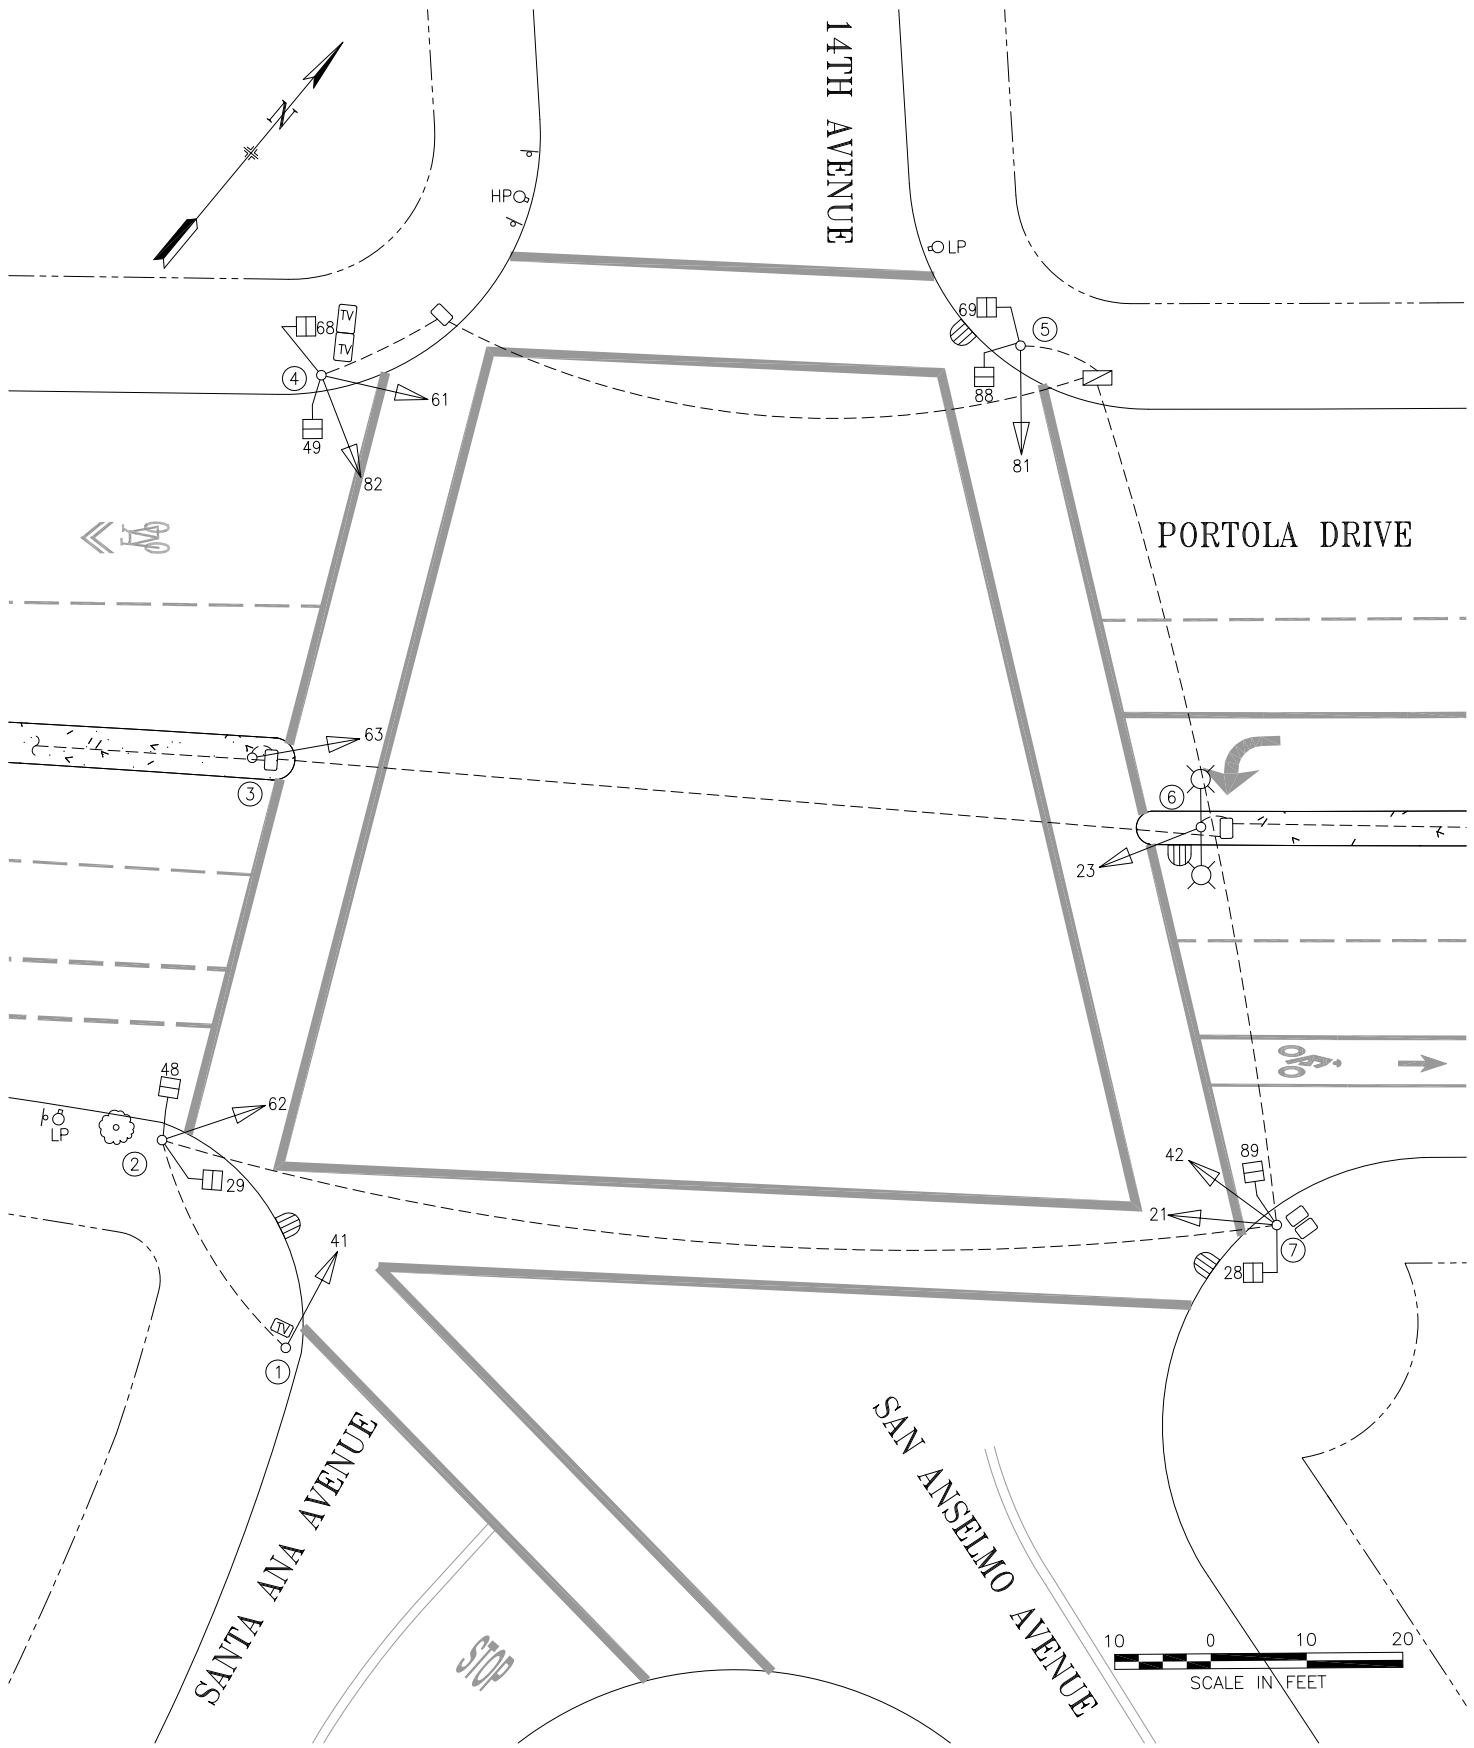

POLE AND EQUIPMENT SCHEDULE

POLE No.	TYPE OF POLE	LUMINAIRE VOLTAGE/ WATTAGE	VEHICLE SIGNAL					PEDESTRIAN SIGNAL			REMARKS
			No.	TYPE	MOUNTING	VISORS	LOUVERS	No.	TYPE	MOUNTING	
1	MARBELITE PEDESTAL SIGNAL POLE (10')		41	3S12"	TV-1-T	T					
2	MARBELITE PEDESTAL SIGNAL POLE (10')		62	3S12"	TV-1-T	T		29 48	1S-COUNT 1S-COUNT	SP-1-SF (12") SP-1(22")	
3	MARBELITE STREET LIGHT W/DUAL LUMINAIRE ARMS		63	3S12"PV	SV-1	FC					
4	MARBELITE PEDESTAL SIGNAL POLE (10')		61 82	3S12" 3S12"	TV-2-T-SFA(22")	T T		49 68	1S-COUNT 1S-COUNT	SP-1-SF(12") SP-1(22")	
5	MARBELITE PEDESTAL SIGNAL POLE (10')		81	3S12"	TV-1-T	T		88 69	1S-COUNT 1S-COUNT	SP-1-SF(12") SP-1(22")	
6	MARBELITE STREET LIGHT W/DUAL LUMINAIRE ARMS		23	3S12"	SV-1	T					
7	MARBELITE PEDESTAL SIGNAL POLE (10')		21 42	3S12" 3S12"	TV-2-T-SFA	T T		89 28	1S-COUNT 1S-COUNT	SP-1-SF(12") SP-1(22")	

NO.	DATE	DESCRIPTION	BY	APP.
0	8/4/15	2543J PUNCHLIST WALKTHROUGH	DY	MV

TABLE OF REVISIONS
CHECK WITH TRACING TO SEE IF YOU HAVE LATEST REVISION

REFERENCE INFORMATION & FILE NO. OF SURVEYS

SAN FRANCISCO MUNICIPAL TRANSPORTATION AGENCY
CITY AND COUNTY OF SAN FRANCISCO

DRAWN: DATE: ASCALES 9/2015
CHECKED: DATE: MVELASCO9/2015

SCALE: AS SHOWN
SHEET OF SHEETS 1 OF 1

TRAFFIC SIGNAL INVENTORY DIAGRAM

14TH AVENUE, PORTOLA DRIVE,
SANTA ANA AVENUE, AND SAN ANSELMO AVENUE

CNN NO. 22943000
REV NO. 0