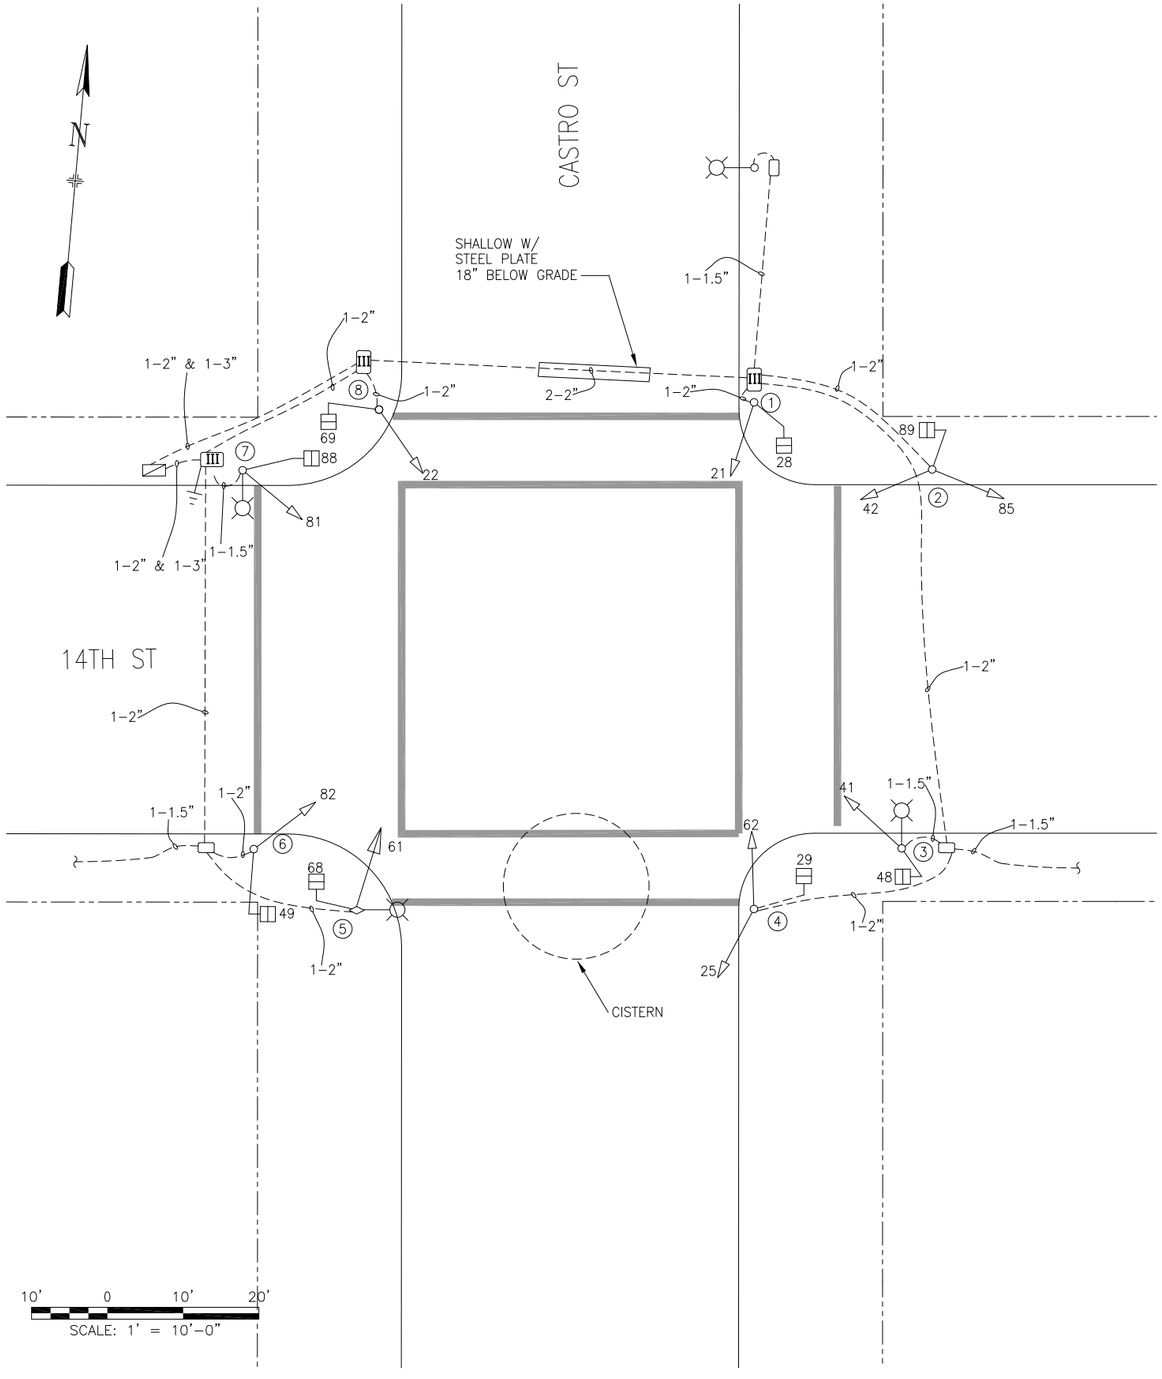

POLE AND EQUIPMENT SCHEDULE

POLE No.	TYPE OF POLE	VEHICLE SIGNAL					PEDESTRIAN SIGNAL			REMARKS
		No.	TYPE	MOUNTING	VISORS	LOUVERS	No.	TYPE	MOUNTING	
1	1-A (10')	21	3S8"	TV-1-T	T		28	1S-COUNT	SP-1	21 MOUNTED ON E SIDE OF POLE
2	MARBLELITE (10')	42 85	3S8" 3S8"	TV-2-T-SF	FC FC		89	1S-COUNT	SP-1	
3	MARBLELITE SL	41	3S8"	SV-1-T	T		48	1S-COUNT	SP-1-T	
4	1-A (10')	25 62	3S8" 3S8"	TV-2-T	T T		29	1S-COUNT	SP-1	
5	MUNI + SL	61	3S12"	SV-1	T		68	1S-COUNT	SP-1	61 MOUNTED ON E SIDE OF POLE
6	MARBLELITE (10')	82	3S8"	TV-1	FC		49	1S-COUNT	SP-1	
7	MARBLELITE SL	81	3S8"	SV-1-T	T		88	1S-COUNT	SP-1-T	
8	1-A (10')	22	3S8"	TV-1	T		69	1S-COUNT	SP-1	

NO.	DATE	DESCRIPTION	BY	APP.
1	5/2/16	SIGNAL #61 REPLACED WITH 3S12"	JH	ET
0	8/15/06	UPGRADED BY 0872J; CONVERTED FROM AS-BUILTS	JH	ET

TABLE OF REVISIONS
CHECK WITH TRACING TO SEE IF YOU HAVE LATEST REVISION

REFERENCE INFORMATION & FILE NO. OF SURVEYS

SAN FRANCISCO MUNICIPAL TRANSPORTATION AGENCY
CITY AND COUNTY OF SAN FRANCISCO

DRAWN: JH DATE: 7/2016
CHECKED: ET DATE: 7/2016

SCALE: AS SHOWN
SHEET OF SHEETS: 1 OF 1

TRAFFIC SIGNAL INVENTORY DIAGRAM
14TH ST & CASTRO ST

CNN NO. 26004000
REV NO. 1