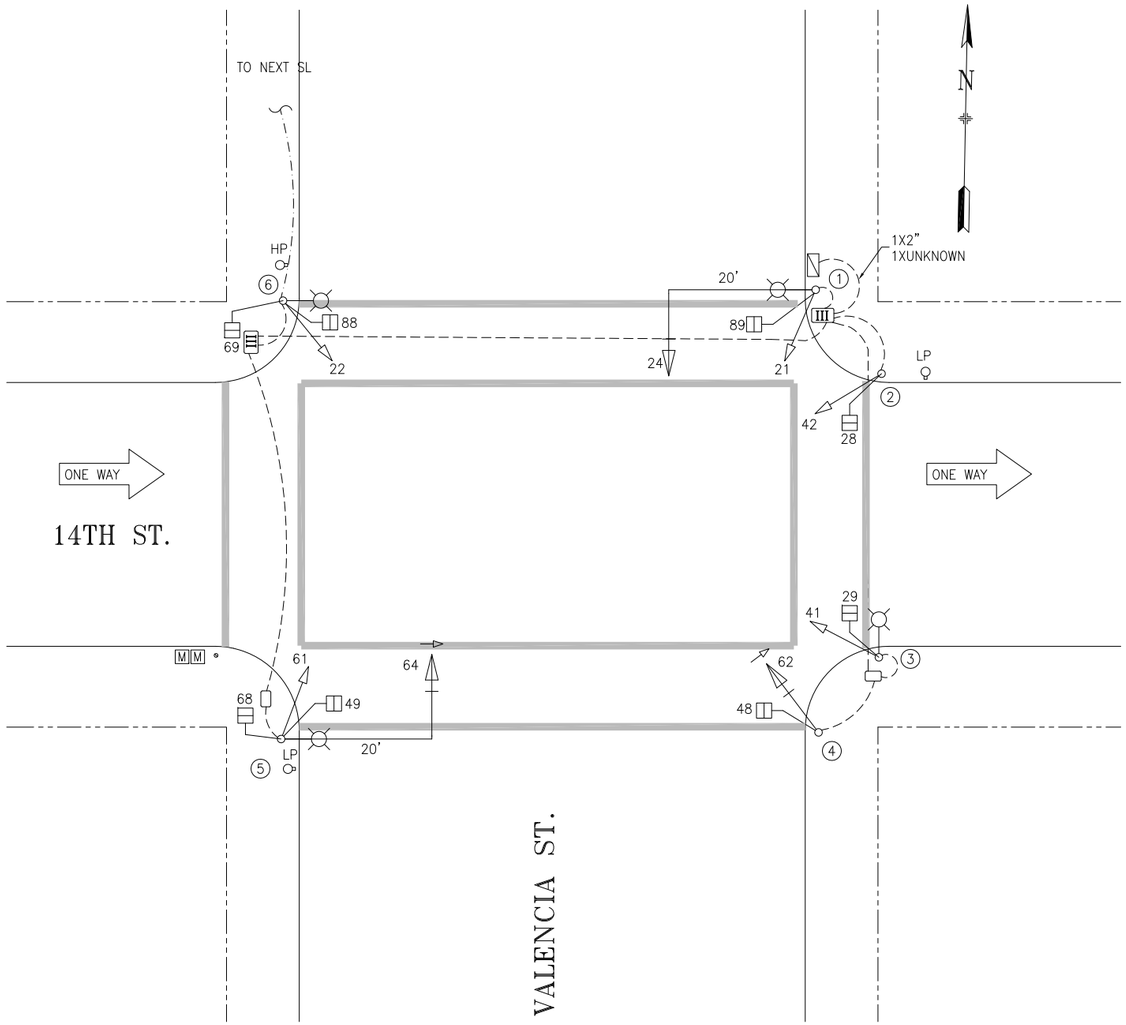

POLE AND EQUIPMENT SCHEDULE

POLE No.	TYPE OF POLE	VEHICLE SIGNAL					PEDESTRIAN SIGNAL			REMARKS
		No.	TYPE	MOUNTING	VISORS	LOUVERS	No.	TYPE	MOUNTING	
1	17B-1-70 WITH 20' MAST ARM AND 6' LUMINAIRE ARM.	24 21	3S12" 3S8"	MAS SV-1-T	T T		89	1S-COUNT	SP-1	BP
2	1-A (10')	42	3S8"	TV-1	T		28	1S-COUNT	SP-1	
3	SL	41	3S8"	SV-1-T	T		29	1S-COUNT	SP-1	
4	1-A (10')	62	4S12"GLA	TV-1-T	T		48	1S-COUNT	SP-1	BP
5	17B-1-70 WITH 20' MAST ARM AND 6' LUMINAIRE ARM.	64 61	4S12"GLA 3S8"	MAS SV-1-T	T T		49 68	1S-COUNT 1S-COUNT	SP-1 SP-1	BP
6	SL	22	3S8"	SV-1-T	T		69 88	1S-COUNT 1S-COUNT	SP-1 SP-1	

NO.	DATE	DESCRIPTION	BY	APP.
1	11/17/04	ACTIVATE ø2P, ø6P; SIGNALS 62 & 64 CHANGED TO 4S12"GLA PER SRC 2004-193; CORRECTED SID 3/20/17	CXL/CH	JK/AH

TABLE OF REVISIONS
CHECK WITH TRACING TO SEE IF YOU HAVE LATEST REVISION

COMPLETION DATE/
ELECTRICIAN INITIAL

DEPARTMENT OF PARKING AND TRAFFIC
DIVISION OF TRAFFIC ENGINEERING
CITY AND COUNTY OF SAN FRANCISCO

DRAWN:	DATE:	SCALE:	TRAFFIC SIGNAL INVENTORY DIAGRAM	CNN NO.
CXL	4/03	1" = 20'		24378000
CHECKED:	DATE:	SHEET OF SHEETS	14TH ST AND VALENCIA	REV. NO.
JK	5/06	1 OF 1		1