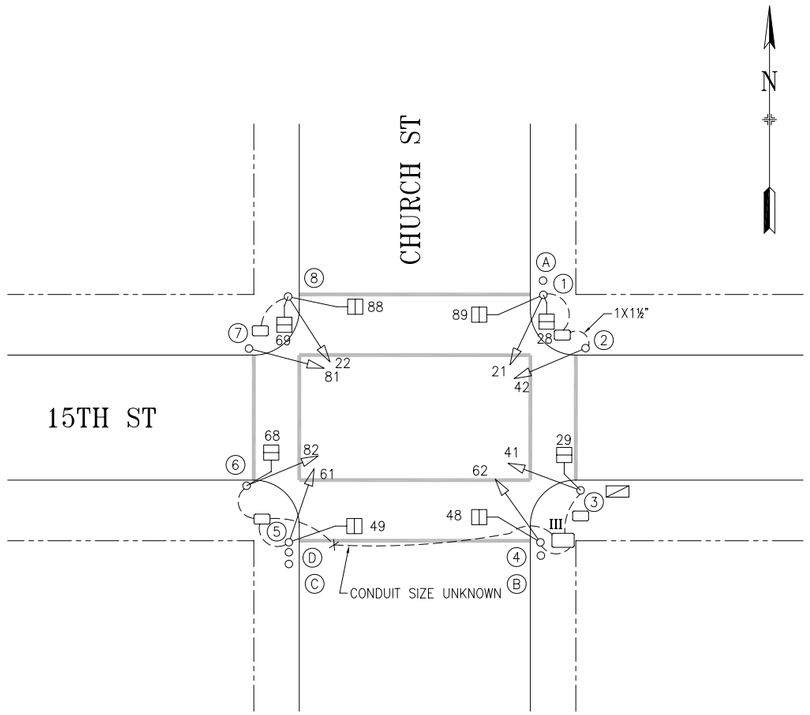

NOTE:
CABINET FOUNDATION TYPE: STD

POLE AND EQUIPMENT SCHEDULE

POLE No.	TYPE OF POLE	VEHICLE SIGNAL					PEDESTRIAN SIGNAL			REMARKS
		No.	TYPE	MOUNTING	VISORS	LOUVERS	No.	TYPE	MOUNTING	
1	1-A (10')	21	3S8"	TV-1	FC		89 28	1S-IN 1S-IN	SP-1 SP-1	
2	UTILITY	42	3S8"	SV-1	FC					
3	1-A (10')	41	3S8"	TV-1	FC		29	1S-IN	SP-1	
4	1-A (10')	62	3S8"	TV-1	FC		48	1S-IN	SP-1	
5	1-A (10')	61	3S8"	TV-1	FC		49	1S-IN	SP-1	
6	1-A (10')	82	3S8"	TV-1	T		68	1S-IN	SP-1	
7	UTILITY	81	3S8"	SV-1	FC					
8	1-A (10')	22	3S8"	TV-1	FC		88 69	1S-IN 1S-IN	SP-1 SP-1	
A	SL									
B	SL									
C	MUNI									
D	UTILITY									

20' 0 20' 40'

NO.	DATE	DESCRIPTION	BY	APP.
2	10/5/10	ADD NEW PED SIGNALS 28, 29, 68, 69 VIA SRC	ET	HQ
1	06/95	SIGNAL MODIFICATION CT22.	CXL	BW

TABLE OF REVISIONS
CHECK WITH TRACING TO SEE IF YOU HAVE LATEST REVISION

COMPLETION DATE / ELECTRICIAN INITIAL

SAN FRANCISCO MUNICIPAL TRANSPORTATION AGENCY
TRANSPORTATION ENGINEERING
CITY AND COUNTY OF SAN FRANCISCO

DRAWN: CXL DATE: 07/09/99
CHECKED: DATE:
SCALE: 1" = 40'
SHEET OF SHEETS 1 OF 1

TRAFFIC SIGNAL INVENTORY DIAGRAM

15TH ST & CHURCH ST

CNN NO. 25727000
REV. NO.

FILE NAME: 15ST_Church.dwg
DATE: Jul 31 2000 10:57
ORIGIN: SECTION
SCALE FACTOR: 240
PLOT SCALE: 1=1
EXTERNAL REFERENCES: tb34x22.dwg
FONTS USED: ROMAND.SHX romans ROMANS.SHX ROMANS.SHX romant.shx
T:\T_E_FILES\Offdal_Records\Signal_Inventory\Current_CAD\SID\15ST_Church.dwg, Layout1, 10/29/2010 3:11:15 PM,