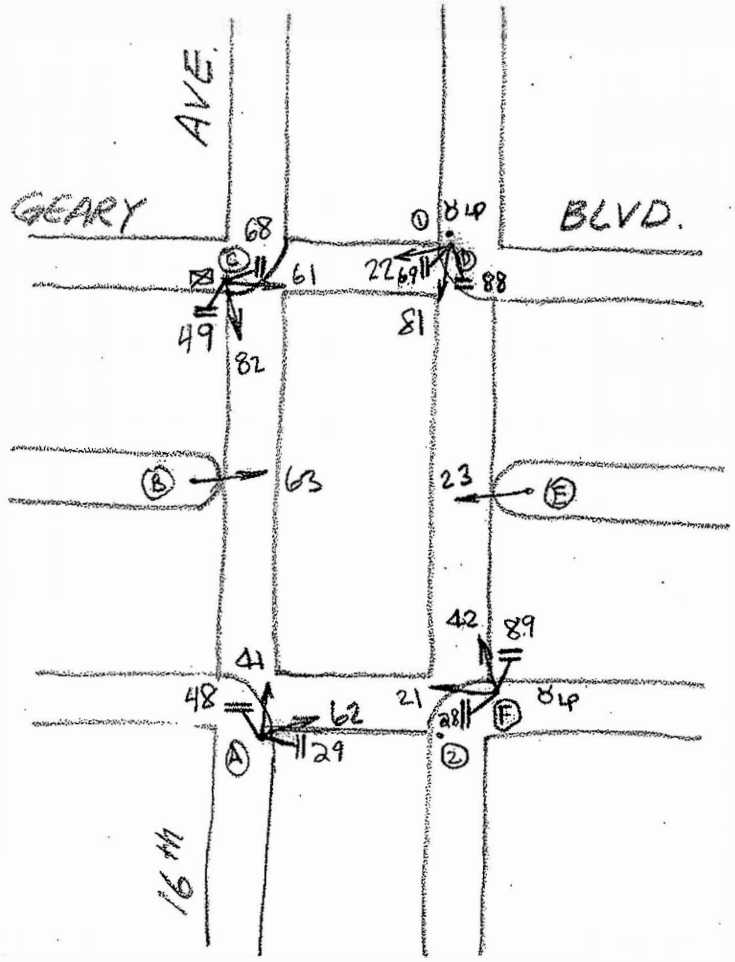

Φ2 ⟶

2020-07-28

POLE	FUNC.	MAT'L
A	S	C
B	L	C
C	S	C
D	S	C
E	L	C
F	S	C
1	U	W
2	U	W

SIGNAL NO.	MAKE	NO. OF SECT.	SIZE	VISOR	B.P. OR LOUVERS	MOUN'T
41	EO	3	12"	T 12"	No	T
62	EO	3	12"	T 12"	NO	T
63	EO	3	12"	T 12"	NO	S
82	EO	3	12"	T 12"	NO	T
61	EO	3	12"	T 12"	No	T
22	EO	3	12"	T 12"	No	T
81	EO	3	12"	T 12"	NO	T
23	EO	3	12"	T 12"	NO	S
42	EO	3	12"	T 12"	NO	T
21	EO	3	12"	T 12"	NO	T

PED SIGNAL NO.	LEGEND	MESSAGE ELEMENT	MESSAGE COLOR	MAKE	MOUN'T
28	COUNT	LED	WH/OR	DIALIGHT	S
29	COUNT	LED	WH/OR	Dialight	S
48	COUNT	LED	WH/OR	Dialight	S
49	COUNT	LED	WH/OR	Dialight	S
68	COUNT	LED	WH/OR	Dialight	S
69	COUNT	LED	WH/OR	Dialight	S
88	COUNT	LED	WH/OR	Dialight	S
89	COUNT	LED	WH/OR	Dialight	S

CONTROLLER CABINET SIZE : ORDINARY BASE CABINET: YES

COMMENTS :

Per field check, updated signals 23, 41, and 62 to 12". Per SRC 2019-331, upgraded remaining signals 21, 22, 42, 61, 63, 81, and 82 to 12". A.Lam - 2020-07-28