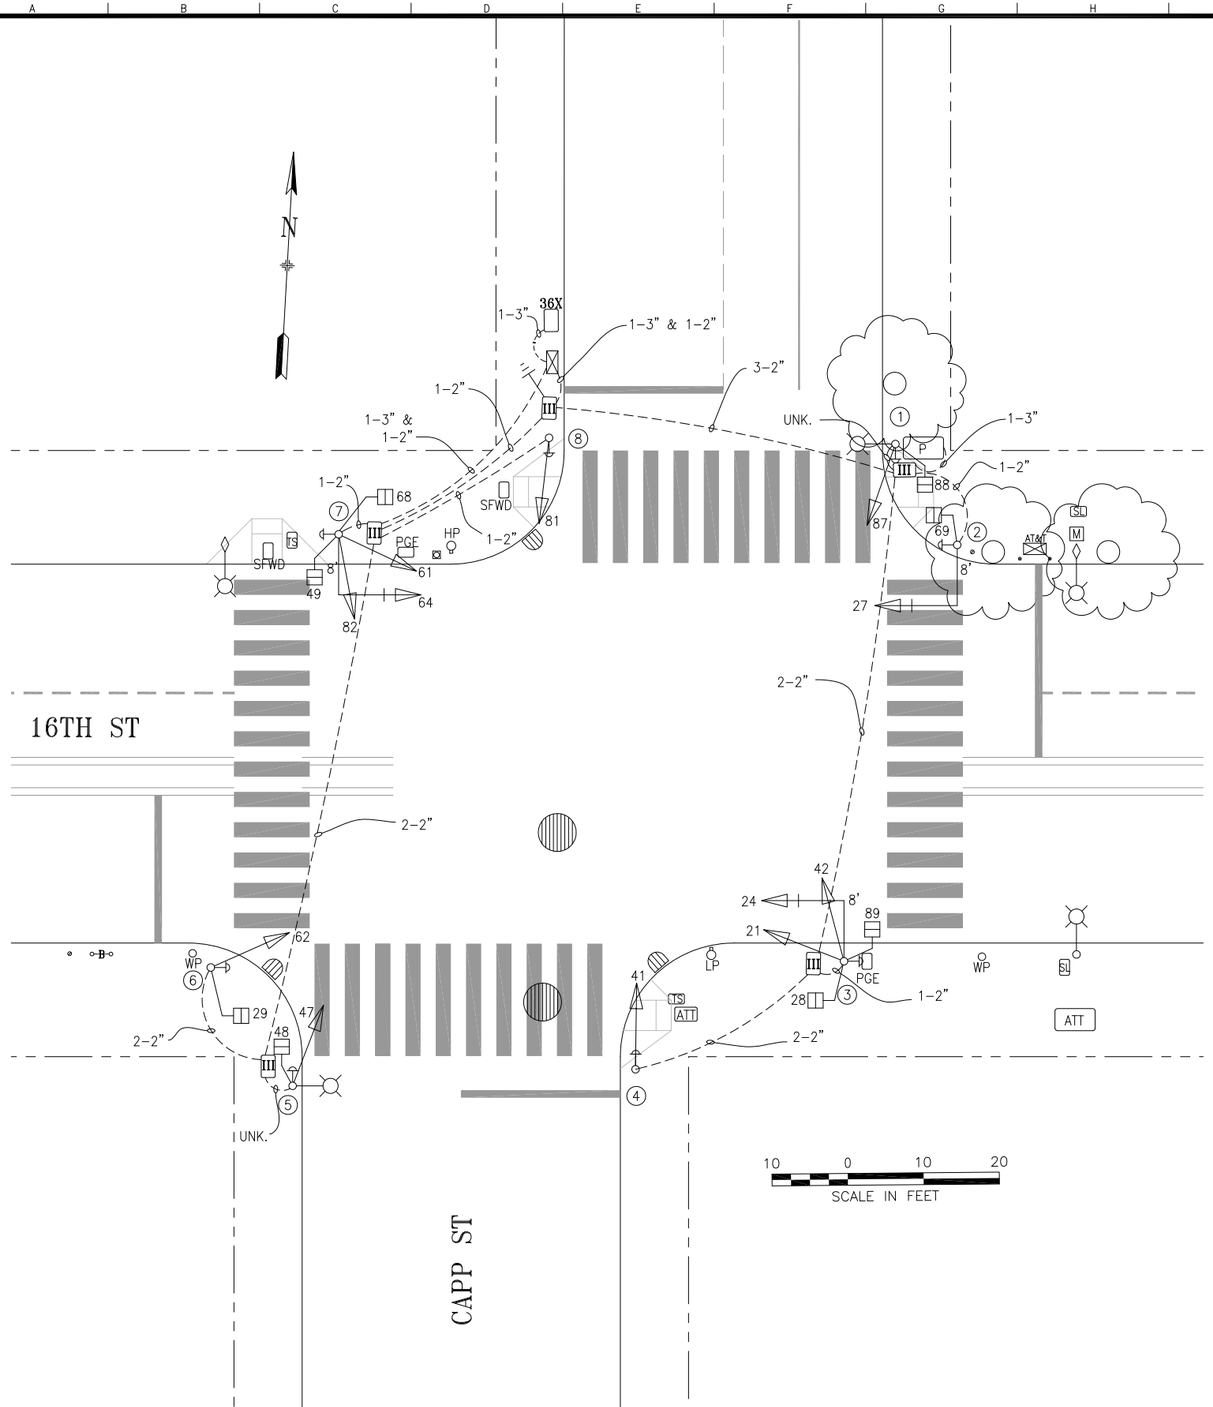

POLE AND EQUIPMENT SCHEDULE

POLE No.	TYPE OF POLE	LUMINAIRE VOLTAGE/ WATTAGE	VEHICLE SIGNAL No.	VEHICLE SIGNAL TYPE	VEHICLE SIGNAL MOUNTING	VEHICLE SIGNAL VISORS	VEHICLE SIGNAL LOUVERS	PEDESTRIAN SIGNAL No.	PEDESTRIAN SIGNAL TYPE	PEDESTRIAN SIGNAL MOUNTING	REMARKS
1	CITY STANDARD STREETLIGHT		87	3S12"	SV-1-T	T		88	1S-COUNT	SP-1	APS PPB
2	16-1-100 WITH 8' MAST ARM		27	3S12"	MAS	T		69	1S-COUNT	SP-1	BACKPLATE APS PPB
3	16-1-100 WITH 8' MAST ARM		21 42 24	3S12" 3S12" 3S12"	SV-2-TA MAS	T T T		89 28	1S-COUNT 1S-COUNT	SP-1 (18") SP-1	BACKPLATE APS PPB
4	1-A (10')		41	3S12"	TV-1-T	T					APS PPB
5	CITY STANDARD STREETLIGHT		47	3S12"	SV-1-T	T		48 20	1S-COUNT 1S-COUNT	SP-1 SP-1	APS PPB
6	1-A (10')		62	3S12"	TV-1-T	T		29	1S-COUNT	SP-1	APS PPB
7	16-1-100 WITH 8' MAST ARM		61 82 64	3S12" 3S12" 3S12"	SV-2-TA MAS	T T T		49 68	1S-COUNT 1S-COUNT	SP-1 (18") SP-1	BACKPLATE APS PPB
8	1-A (10')		81	3S12"	TV-1-T	T					APS PPB

NO.	DATE	DESCRIPTION	BY	APP.
0	10/30/14	ACTIVATED THRU 2246J; CONVERTED FROM CONTRACT PLANS	JH	MV

TABLE OF REVISIONS
CHECK WITH TRACING TO SEE IF YOU HAVE LATEST REVISION

REFERENCE INFORMATION & FILE NO. OF SURVEYS

SAN FRANCISCO MUNICIPAL TRANSPORTATION AGENCY
CITY AND COUNTY OF SAN FRANCISCO

DRAWN: JH DATE: 08/15
CHECKED: MV DATE: 08/15

SCALE: AS SHOWN
SHEET OF SHEETS 1 OF 1

TRAFFIC SIGNAL INVENTORY DIAGRAM
16TH AND CAPP STREETS

CNN NO. 24168000
REV NO. 0