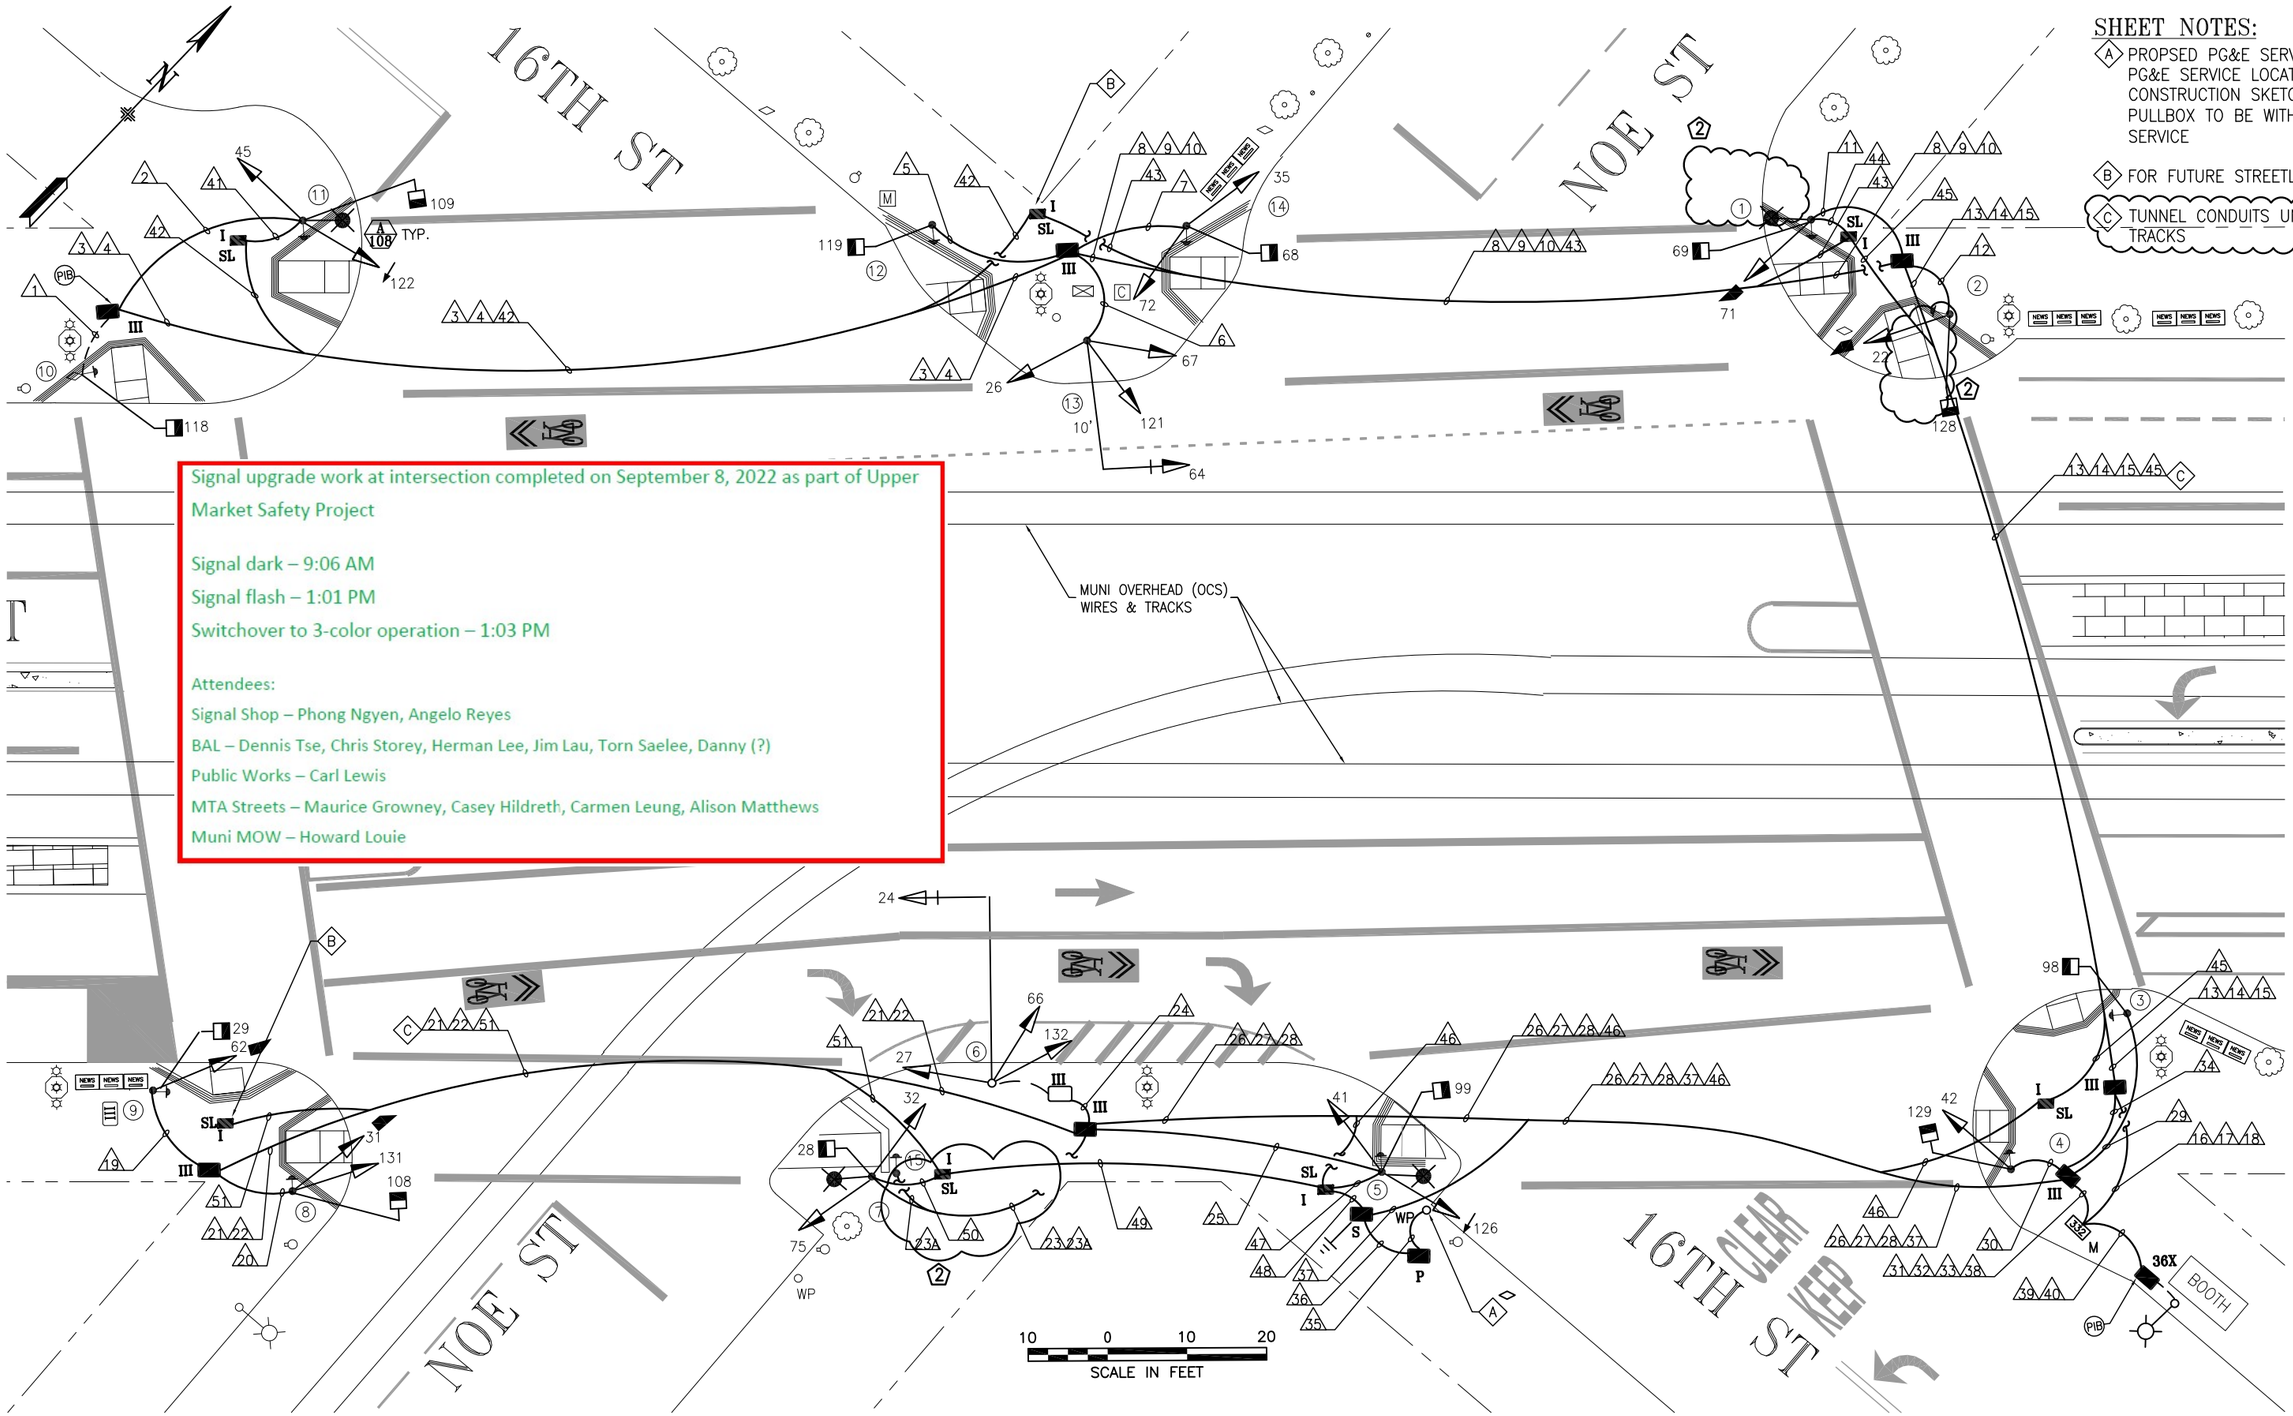

Signal upgrade work at intersection completed on September 8, 2022 as part of Upper Market Safety Project

Signal dark – 9:06 AM

Signal flash – 1:01 PM

Switchover to 3-color operation – 1:03 PM

Attendees:

Signal Shop – Phong Ngyen, Angelo Reyes

BAL – Dennis Tse, Chris Storey, Herman Lee, Jim Lau, Torn Saelee, Danny (?)

Public Works – Carl Lewis

MTA Streets – Maurice Growney, Casey Hildreth, Carmen Leung, Alison Matthews

Muni MOW – Howard Louie

SHEET NOTES:

(A) PROPSED PG&E SERVICE POINT. EXACT PG&E SERVICE LOCATION PER PG&E CONSTRUCTION SKETCH. CITY SERVICE PULLBOX TO BE WITHIN 5' OF PG&E SERVICE

(B) FOR FUTURE STREETLIGHT CONNECTION

(C) TUNNEL CONDUITS UNDER STREETCAR TRACKS (1)

NO.	DATE	DESCRIPTION	BY	APP.
2	12/06/21	NEW PPB#15, REUSE POLE #6, SWAP 69/128	MG	GL
1	10/14/20	ADDENDUM #2	GL	SL

TABLE OF REVISIONS
CHECK WITH TRACING TO SEE IF YOU HAVE LATEST REVISION

REFERENCE INFORMATION & FILE NO. OF SURVEYS

CITY AND COUNTY OF SAN FRANCISCO

SAN FRANCISCO PUBLIC WORKS

BUREAU OF ENGINEERING
CITY & COUNTY OF SAN FRANCISCO
SAN FRANCISCO PUBLIC WORKS
49 SOUTH VAN NESS AVENUE, SUITE 800
SAN FRANCISCO, CA 94103 - 1226

		Date:
Acting Section Mgr:	CHI IAO	
Acting Deputy Bureau Mgr:	LESLEY WONG	
Acting Bureau Mgr:	IQBAL DHAPA	

DESIGNED:	MG/DG	DATE: 03/2020
DRAWN:	JC/DG	DATE: 03/2020
CHECKED:	MG/SL	DATE: 03/2020

REGISTERED PROFESSIONAL ENGINEER
CHI KEONG TAO
NO. E19134
ELECTRICAL
STATE OF CALIFORNIA

SCALE: AS SHOWN

SHEET OF SHEETS: 87 OF 126

UPPER MARKET CORRIDOR SAFETY IMPROVEMENTS PROJECT

MARKET ST AND NOE ST/16TH ST TRAFFIC SIGNAL PLAN

CONTRACT ID NO. 1000017336

DRAWING NO. ET-1.1

FILE NO. 116,919

REV. NO. 2