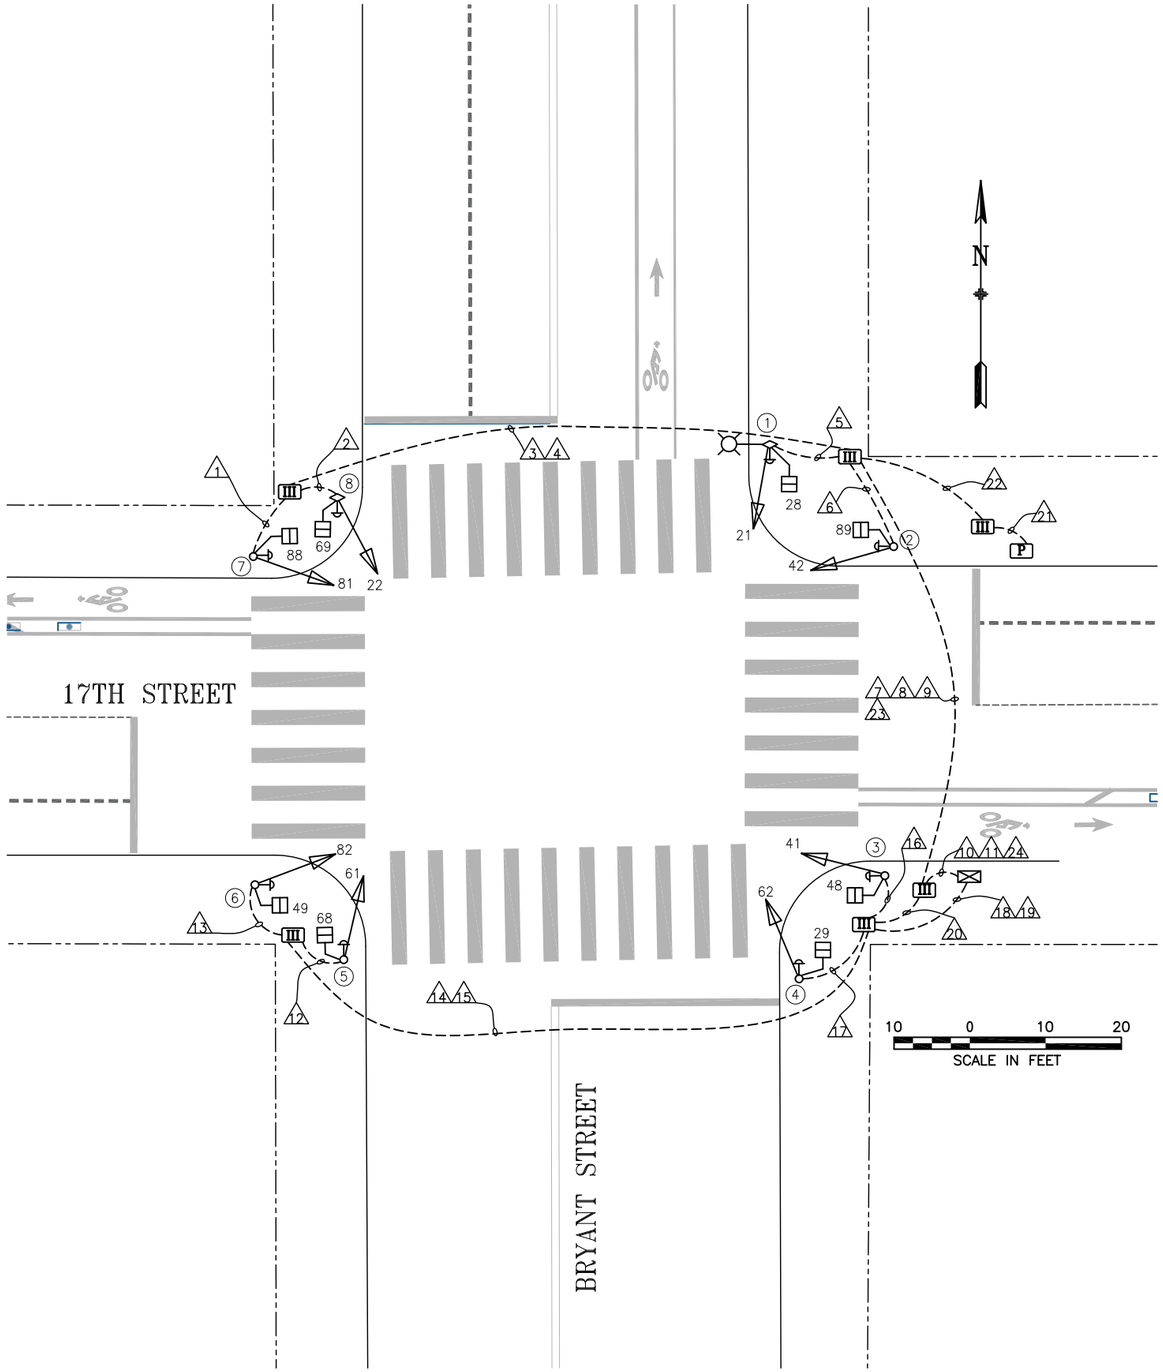

POLE AND EQUIPMENT SCHEDULE

POLE No.	TYPE OF POLE	LUMINAIRE TYPE	VEHICLE SIGNAL					PEDESTRIAN SIGNAL			REMARKS
			No.	TYPE	MOUNTING	VISORS	LOUVERS/BP	No.	TYPE	MOUNTING	
1	TROLLEY POLE		21	3S12"	SV-1-T	T		28	1S-COUNT	SP-1	EXTERNAL CONDUIT APS
2	1-A (10')		42	3S12"	TV-1-T	T		89	1S-COUNT	SP-1	APS
3	1-A (10')		41	3S12"	TV-1-T	T		48	1S-COUNT	SP-1	APS
4	1-A (10')		62	3S12"	TV-1-T	T		29	1S-COUNT	SP-1	APS
5	1-A (10')		61	3S12"	TV-1-T	T		68	1S-COUNT	SP-1	APS
6	1-A (10')		82	3S12"	TV-1-T	T		49	1S-COUNT	SP-1	APS
7	1-A (10')		81	3S12"	TV-1-T	T		88	1S-COUNT	SP-1	APS
8	TROLLEY POLE		22	3S12"	SV-1-T	T		69	1S-COUNT	SP-1	EXTERNAL CONDUIT APS

NO.	DATE	DESCRIPTION	BY	APPROVED
0	03/05/20	CONVERTED FROM CONTRACT: NEW SIGNAL ACTIVATED THROUGH 1303R	S. ARIAS	D. ALABA

TABLE OF REVISIONS
CHECKOUT DRAWING THROUGH THE SID CUSTODIAN FOR THE LATEST REVISION

SEAL OF THE CITY AND COUNTY OF SAN FRANCISCO

SFMTA

DRAWN BY: S. ARIAS DATE: 8/25/21
CHECKED BY: D. ALABA DATE: 6/6/23

SCALE: AS SHOWN
SHEET OF SHEETS: 01 OF 02

TRAFFIC SIGNAL INVENTORY DIAGRAM
17TH STREET AND BRYANT STREET

CNN NO: 24044000
REV NO: 0

CONDUIT AND WIRING SCHEDULE (FURNISH AND INSTALL CONDUIT AND WIRES)

CONDUIT RUN NUMBER		1	2	3	4	5	6	7	8	9	10	11	12	13	14	15	16	17	18	19	20	21	22	23	24																		
CONDUIT SIZE (INCH)		2	1	2	2	1	2	2	2	2	3	2	2	2	2	2	2	2	3	2	2	2	2	2	2																		
NOTES			GRS		SP	GRS				SP		SP				SP				SP	SP																						
POLE 7	VEHICLE SIGNAL 81	3		3				3			3																																
POLE 7	PED SIGNAL 88	2		2				2			2																																
POLE 7	APS PPB FOR XING 17TH ST WS	2		2				2			2																																
POLE 8	VEH SIGNAL 22		3	3				3			3																																
POLE 8	PED SIGNAL 69		2	2				2			2																																
POLE 8	APS PPB FOR XING BRYANT ST NS		2	2				2			2																																
POLE 1	VEHICLE SIGNAL 21					3			3		3																																
POLE 1	PED SIGNAL 28					2			2		2																																
POLE 1	APS PPB FOR XING BRYANT ST NS					2			2		2																																
POLE 2	VEHICLE SIGNAL 42						3		3		3																																
POLE 2	PED SIGNAL 89						2		2		2																																
POLE 2	APS PPB FOR XING 17TH ST ES						2		2		2																																
POLE 5	VEHICLE SIGNAL 61												3		3				3																								
POLE 5	PED SIGNAL 68												2		2				2																								
POLE 5	APS PPB FOR XING BRYANT ST SS												2		2				2																								
POLE 6	VEHICLE SIGNAL 82													3	3				3																								
POLE 6	PED SIGNAL 49													2	2				2																								
POLE 6	APS PPB FOR XING 17TH ST WS													2	2				2																								
POLE 3	VEHICLE SIGNAL 41																3		3																								
POLE 3	PED SIGNAL 48																2		2																								
POLE 3	APS PPB FOR XING 17TH ST ES																2		2																								
POLE 4	VEHICLE SIGNAL 62																	3	3																								
POLE 4	PED SIGNAL 29																	2	2																								
POLE 4	APS PPB FOR XING BRYANT ST SS																	2	2																								
	#14 NEUTRAL	2	2			2	2						2	2			2	2																									
	#14 SPARE			3				3			3				3				3																								
	TOTAL #14 WIRES	9	9	17		9	9	17	14		31		9	9	17		9	9	31																								
	#10 WIRES NEUTRAL			1				1	1		2				1				2																								
	#6 WIRES (120 V SERVICE)																					2	2	2	2																		
	CONDUIT RUN NUMBER	1	2	3	4	5	6	7	8	9	10	11	12	13	14	15	16	17	18	19	20	21	22	23	24																		

NO.	DATE	DESCRIPTION	BY	APPROVED
0	03/05/20	CONVERTED FROM CONTRACT: NEW SIGNAL ACTIVATED THROUGH 1303R	S. ARIAS	D. ALABA

TABLE OF REVISIONS
CHECKOUT DRAWING THROUGH THE SID CUSTODIAN FOR THE LATEST REVISION

SFMTA

DRAWN BY: S. ARIAS DATE: 8/25/21
CHECKED BY: D. ALABA DATE: 6/6/23

SCALE: N/A
SHEET OF SHEETS: 02 OF 02

TRAFFIC SIGNAL INVENTORY DIAGRAM

17TH STREET AND BRYANT STREET

CNN NO: 24044000
REV NO: 0