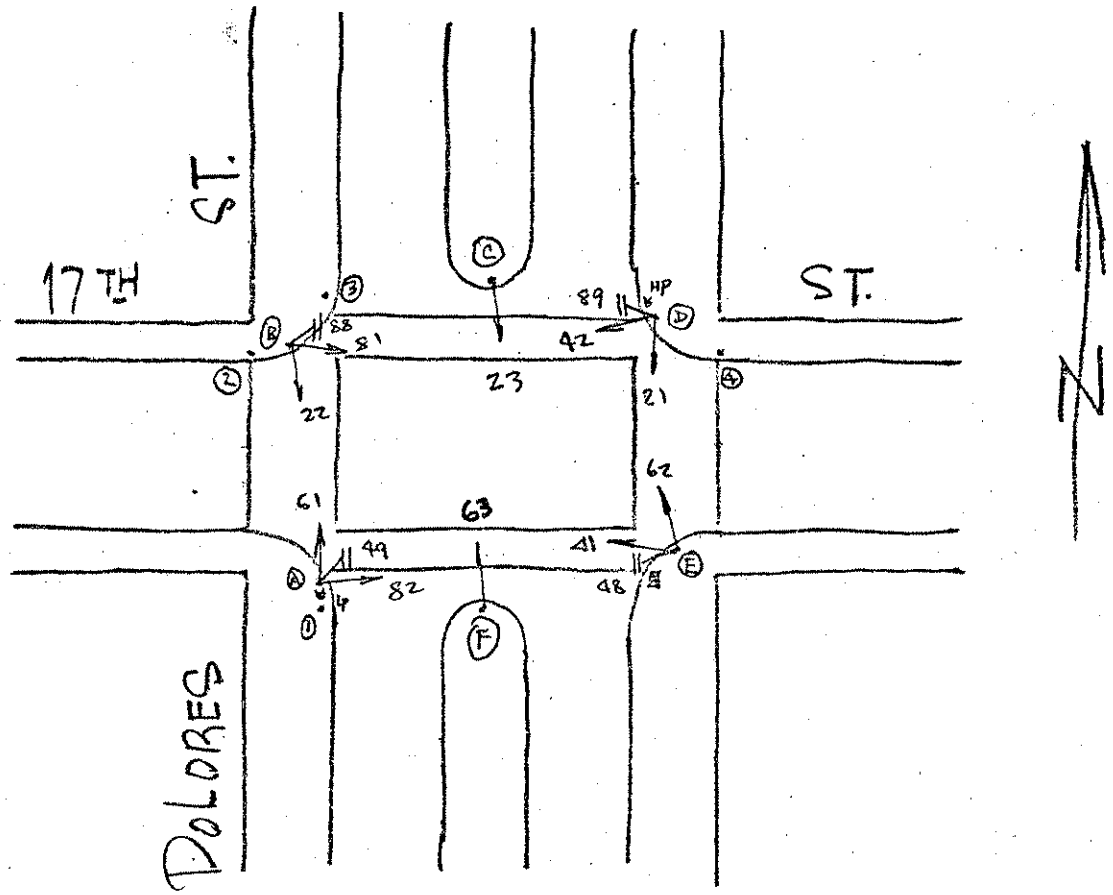


Ø2

S-22-79

| POLE | FUNC. | MAT'L |
|---|---|---|
| A | S | S |
| B | S | S |
| C | S | S |
| D | S | S |
| E | S | S |
| F | S | S |
| | | |
| 1 | U | W |
| 2 | U | W |
| 3 | L | S |
| 4 | U | W |

| SIGNAL NO. | MAKE | NO. OF SECT. | SIZE | VISOR | B.P. OR LOUVERS | MOUN'T |
|---|---|---|---|---|---|---|
| 82 | EC | 3 | 8" | FC 8" | NO | T |
| 61 | EC | 3 | 8" | FC 8" | NO | T |
| 22 | EC | 3 | 8" | FC 8" | NO | T |
| 81 | EC | 3 | 8" | FC 8" | NO | T |
| 23 | EC | 3 | 8" | FC 8" | NO | T |
| 42 | EC | 3 | 8" | FC 8" | NO | T |
| 21 | EC | 3 | 8" | FC 8" | NO | T |
| 62 | EC | 3 | 8" | FC 8" | NO | T |
| 41 | EC | 3 | 8" | FC 8" | NO | T |
| 63 | GO | 3 | 8" | FC 8" | NO | T |

| PED SIGNAL NO. | LEGEND | MESSAGE ELEMENT | MESSAGE COLOR | MAKE | MOUN'T |
|---|---|---|---|---|---|
| 49 | W/W | B.T. | G/R | ES | S |
| 88 | W/W | B.T. | G/R | ES | S |
| 89 | W/W | B.T. | G/R | ES | S |
| 48 | W/W | B.T. | G/R | ES | S |

CONTROLLER CABINET SIZE : ORDINARY BASE CABINET: NO

COMMENTS :