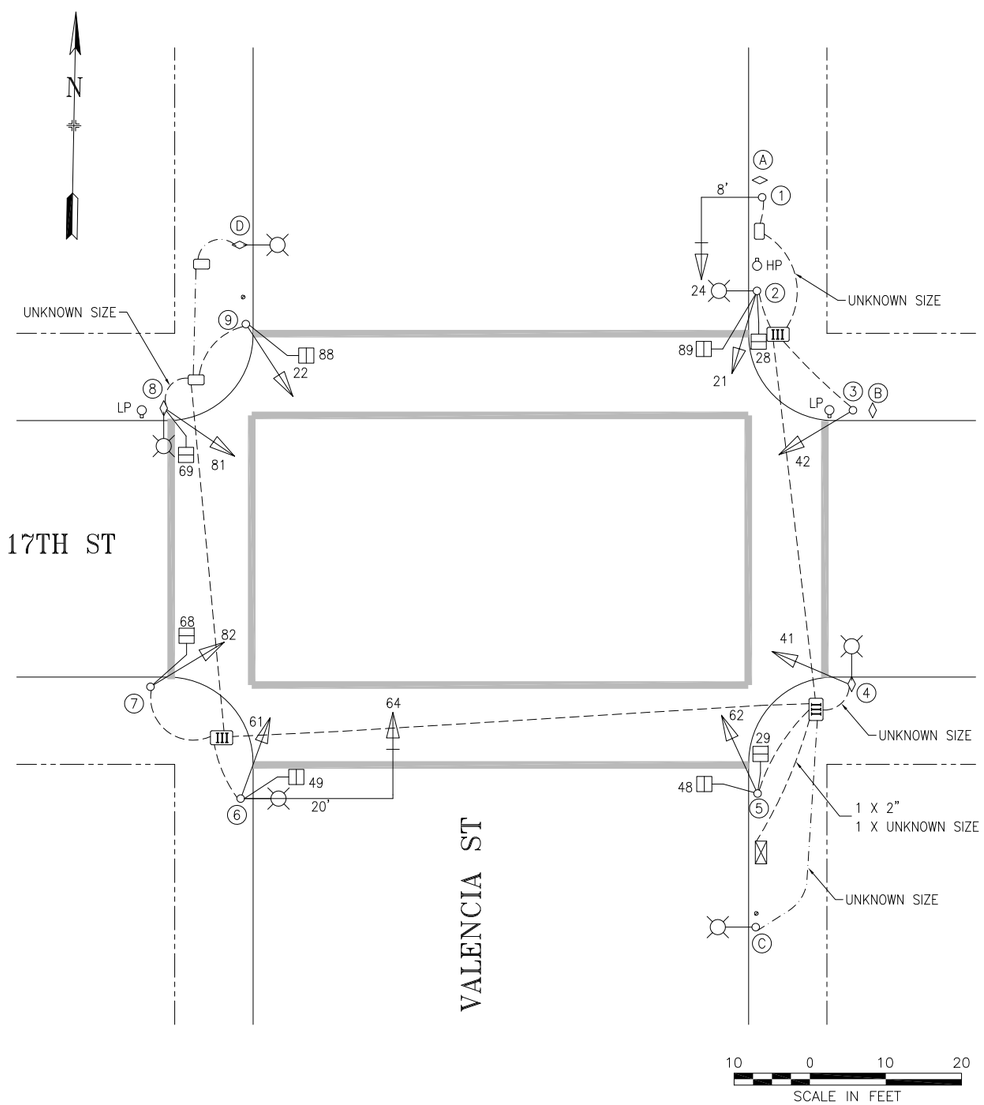

POLE AND EQUIPMENT SCHEDULE

POLE No.	TYPE OF POLE	VEHICLE SIGNAL					PEDESTRIAN SIGNAL			REMARKS
		No.	TYPE	MOUNTING	VISORS	LOUVERS/BP	No.	TYPE	MOUNTING	
1	16-1-70 WITH 8' MAST ARM	24	3S12"	MAS	T	BP				
2	SL	21	3S12"	SV-1-T	T		28 89	1S-COUNT 1S-COUNT	SP-1(22") SP-1-SF(12")	
3	1-A (10')	42	3S12"	TV-1-T	T					
4	SL + MUNI	41	3S12"	SV-1-T	T					
5	1-A (10')	62	3S12"	TV-1-T	T		29 48	1S-COUNT 1S-COUNT	SP-1 SP-1	
6	16-1-70 WITH 20' MAST ARM AND 6' LUMINAIRE ARM.	64 61	3S12" 3S12"	MAS SV-1-T	T T	BP	49	1S-COUNT	SP-1	
7	1-A (10')	82	3S12"	TV-1-T	T		68	1S-COUNT	SP-1-SF(12")	
8	SL + MUNI	81	3S12"	SV-1-T	T		69	1S-COUNT	SP-1	
9	1-A (10')	22	3S12"	TV-1-T	T		88	1S-COUNT	SP-1	
A	MUNI POLE									
B	MUNI POLE									
C	SL									
D	SL + MUNI									

NO.	DATE	DESCRIPTION	BY	APPROVED
3	6/9/23	SRC 2023-043: UPGRADE ALL SIGNALS MOUNTED AT 10FT FROM 8 TO 12-INCH	D. YEUNG	G. DE LEON
2	2/9/23	PER FIELD CHECK – UPDATE MOUNTING FOR 28,89,68 & CABINET TO M-SF	D. YEUNG	G. DE LEON
1	07/05	ADD ADDTIONAL PED SIGNALS BY SIGNAL SHOP.	C. LEUNG	J. KROLL

TABLE OF REVISIONS
CHECKOUT DRAWING THROUGH THE SID CUSTODIAN FOR THE LATEST REVISION

SEAL OF THE CITY AND COUNTY OF SAN FRANCISCO

SFMTA

DRAWN BY: C. LEUNG DATE: 4/03
CHECKED BY: J KROLL DATE: 5/06

SCALE: AS SHOWN
SHEET OF SHEETS: 1 OF 1

TRAFFIC SIGNAL INVENTORY DIAGRAM

17TH ST AND VALENCIA ST

CNN NO: 24174000
REV NO: 3