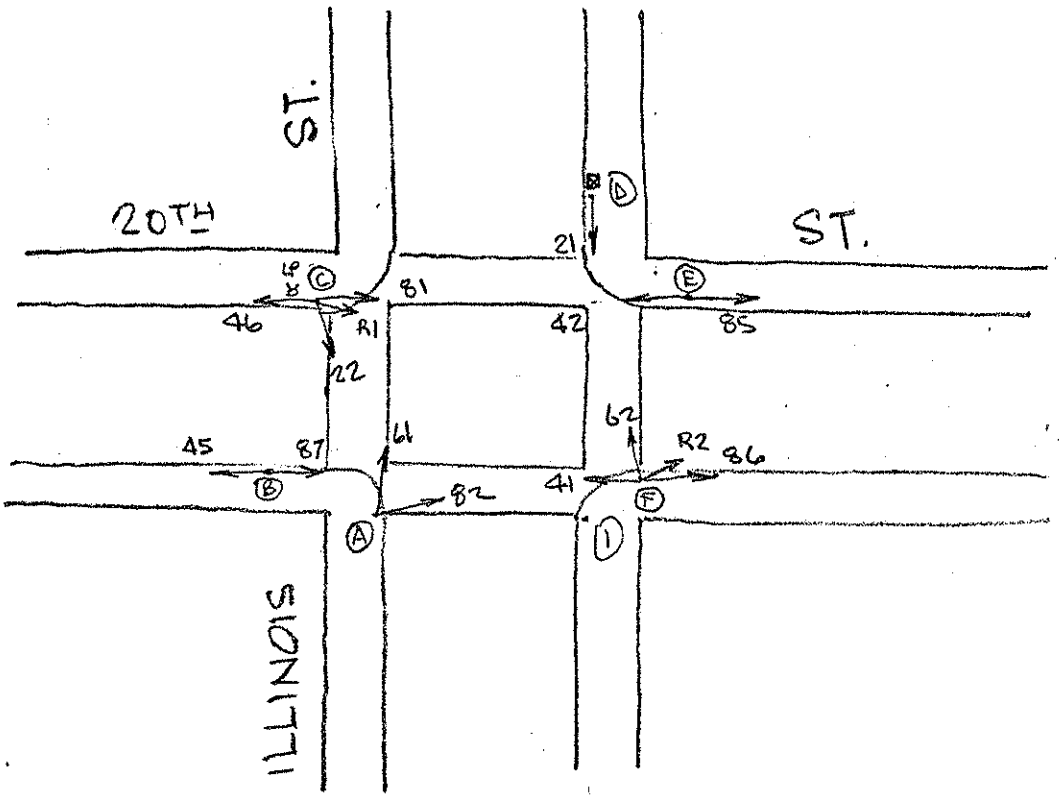

#2

5-7-79

POLE	FUNC.	MAT'L
A	S	S
B	S	S
C	S	S
D	S	S
E	S	S
F	S	S
I	U	W

SIGNAL NO.	MAKE	NO. OF SECT.	SIZE	VISOR	B.P. OR LOUVERS	MOUN'T
82	EA	3	8" R,Y,Y	FC 8"	No	T
61	EA	3	8" R,RX,GX	FC 8"	NO	T
87	EA	3	8" R,Y,Y	FC 8"	NO	T
45	EA	3	8" R,Y,Y	FC 8"	No	T
46	EA	3	8" R,Y,Y	FC 8"	No	T
22	EA	3	8" R,RX,GX	FC 8"	NO	T
81	EA	3	8" R,Y,Y	FC 8"	NO	T
R1	EA	2	8" RX,GX	FC 8"	NO	T
21	EA	3	8" R,RX,GX	FC 8"	NO	T
42	EA	3	8" R,Y,Y	FC 8"	NO	T
85	EA	5	8" R,Y,Y,RX,GX	FC 8"	NO	T
86	EA	3	8" R,Y,Y	FC 8"	NO	T
62	EA	3	8" R,RX,GX	FC 8"	NO	T
41	EA	3	8" R,Y,Y	FC 8"	NO	T
R2	EA	2	8" RX,GX	FC 8"	NO	T

PED SIGNAL NO.	LEGEND	MESSAGE ELEMENT	MESSAGE COLOR	MAKE	MOUN'T

CONTROLLER CABINET SIZE: ORDINARY BASE CABINET: YES

COMMENTS: