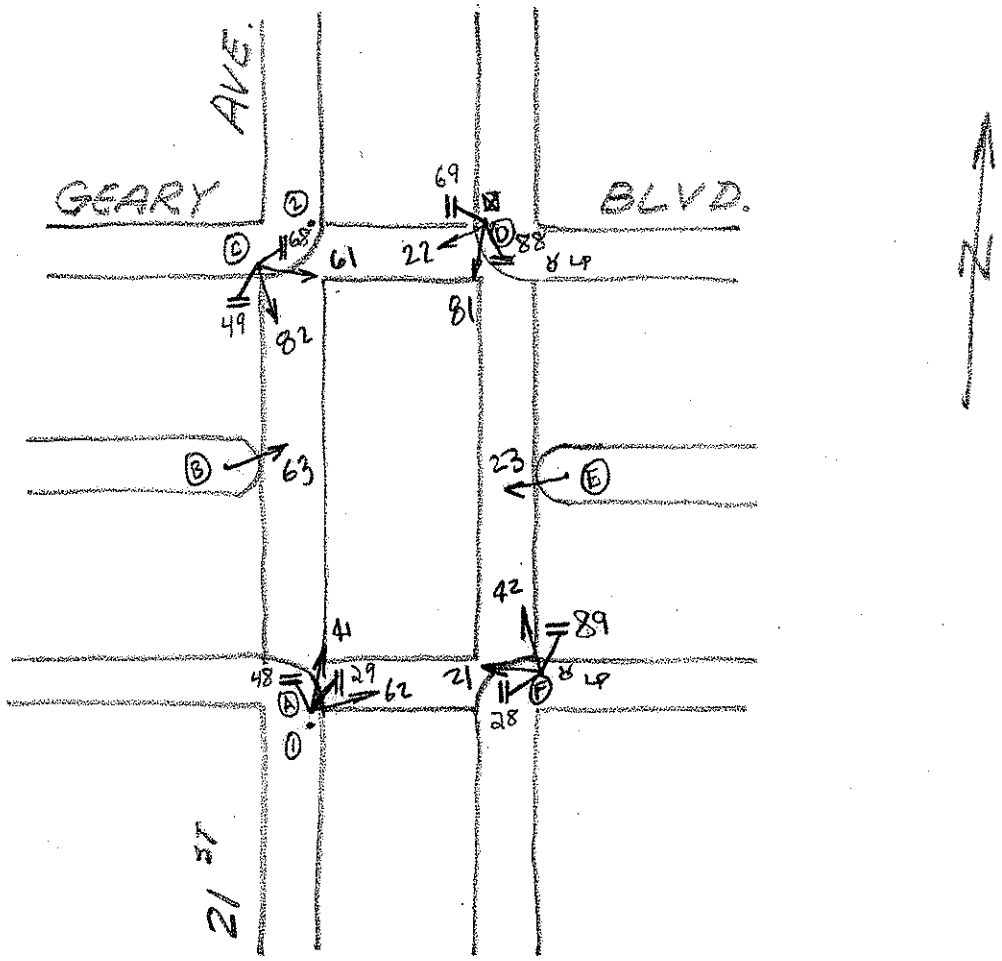

Φ2 →

7-06-04

POLE	FUNC.	MAT'L
A	S	C
B	L	C
C	S	C
D	S	C
E	L	C
F	S	C
1	U	W
2	U	W

SIGNAL NO.	MAKE	NO. OF SECT.	SIZE	VISOR	B.P. OR LOUVERS	MOUN'T
41	EO	3	8"	FC 8"	NO	T
62	EO	3	8"	FC8"	NO	T
63	EO	3	8"	FC 8"	NO	S
82	EO	3	8"	FC8"	NO	T
61	EO	3	8"	FC 8"	B.P.	T
22	EO	3	8"	FC 8"	NO	T
81	EO	3	8"	FC 8"	NO	T
23	EC	3	8"	FC 8"	NO	S
42	EO	3	8"	FC8"	NO	T
21	EO	3	8"	FC8"	NO	T

PED SIGNAL NO.	LEGEND	MESSAGE ELEMENT	MESSAGE COLOR	MAKE	MOUN'T
28	COUNT	LED	WH/OR	Dialight	S
29	COUNT	LED	WH/OR	Dialight	S
48	COUNT	LED	WH/OR	Dialight	S
49	COUNT	LED	WH/OR	Dialight	S
68	COUNT	LED	WH/OR	Dialight	S
69	COUNT	LED	WH/OR	Dialight	S
88	COUNT	LED	WH/OR	Dialight	S
89	COUNT	LED	WH/OR	Dialight	S

CONTROLLER CABINET SIZE : ORDINARY BASE CABINET: YES

COMMENTS: ADDED COUNTDOWN PED SIGNALS FOR ALL DIRECTIONS