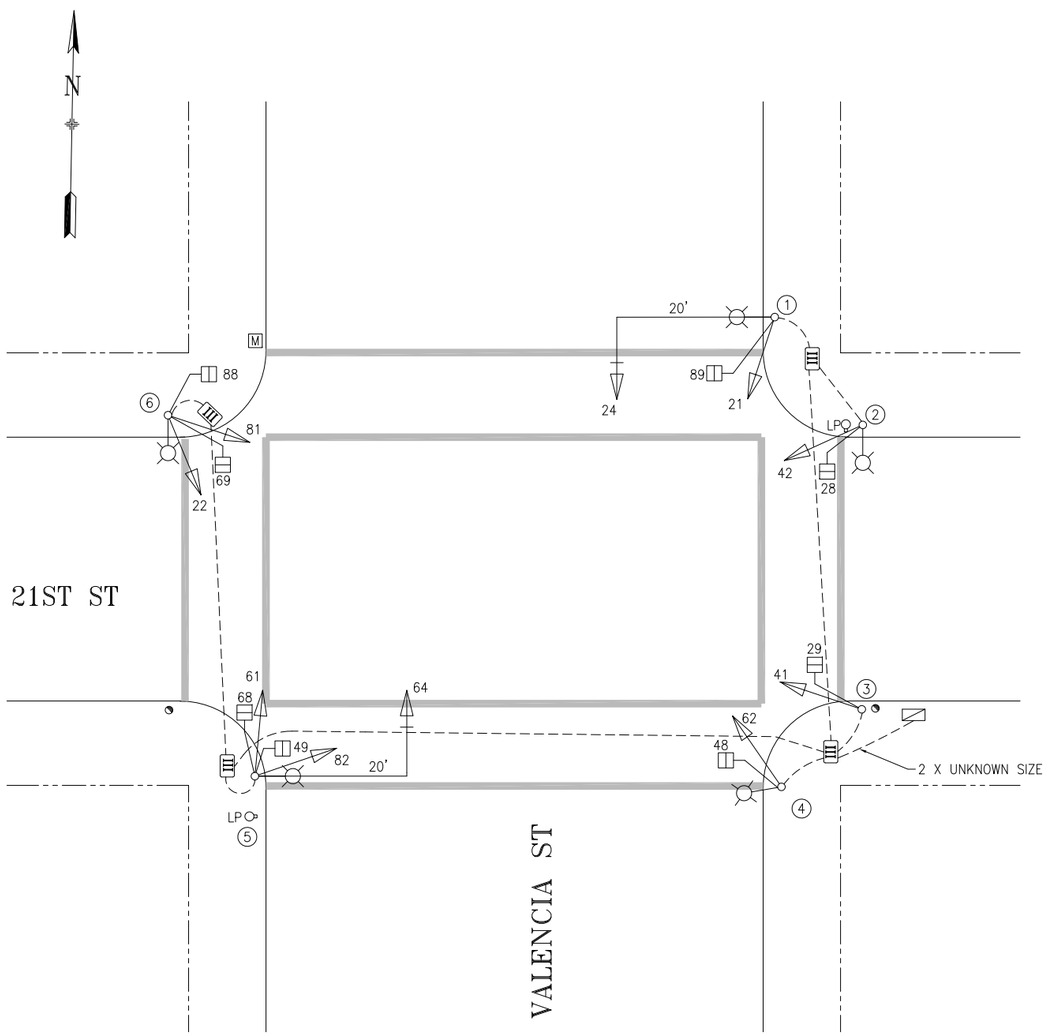

POLE AND EQUIPMENT SCHEDULE

POLE No.	TYPE OF POLE	VEHICLE SIGNAL					PEDESTRIAN SIGNAL			REMARKS
		No.	TYPE	MOUNTING	VISORS	LOUVERS/BP	No.	TYPE	MOUNTING	
1	17B-1-70 WITH 20' MAST AND 6' LUMINAIRE ARMS.	24 21	3S12" 3S12"	MAS SV-1-T MOUNTED AT 9.5'	T T	BP	89	1S-COUNT	SP-1	
2	SL	42	3S12"	SV-1-T	T		28	1S-COUNT	SP-1	
3	1-A (10')	41	3S12"	TV-1-T	T		29	1S-COUNT	SP-1	
4	SL	62	3S12"	SV-1-T	T		48	1S-COUNT	SP-1	
5	17B-1-70 WITH 20' MAST AND 6' LUMINAIRE ARMS.	64 61 82	3S12" 3S12" 3S12"	MAS SV-2-TA	T T T	BP	49 68	1S-COUNT 1S-COUNT	SP-1 SP-1	
6	SL	81 22	3S12" 3S12"	SV-2-TA	T T		69 88	1S-COUNT 1S-COUNT	SP-1 SP-1	

NO.	DATE	DESCRIPTION	BY	APPROVED
2	6/9/23	SRC 2023-044: UPGRADE ALL SIGNALS MOUNTED AT 10FT FROM 8 TO 12-INCH	D. YEUNG	G. DE LEON
1	07/05	ADD ADDTIONAL PED SIGNALS BY SIGNAL SHOP.	C. LEUNG	J. KROLL

TABLE OF REVISIONS
CHECKOUT DRAWING THROUGH THE SID CUSTODIAN FOR THE LATEST REVISION

SEAL OF THE CITY AND COUNTY OF SAN FRANCISCO

SFMTA

DRAWN BY: C. LEUNG DATE: 4/03
CHECKED BY: J. KROLL DATE: 5/06

SCALE: 1" = 20'
SHEET OF SHEETS: 1 OF 1

TRAFFIC SIGNAL INVENTORY DIAGRAM

21ST ST AND VALENCIA ST

CNN NO: 24119000
REV NO: 2