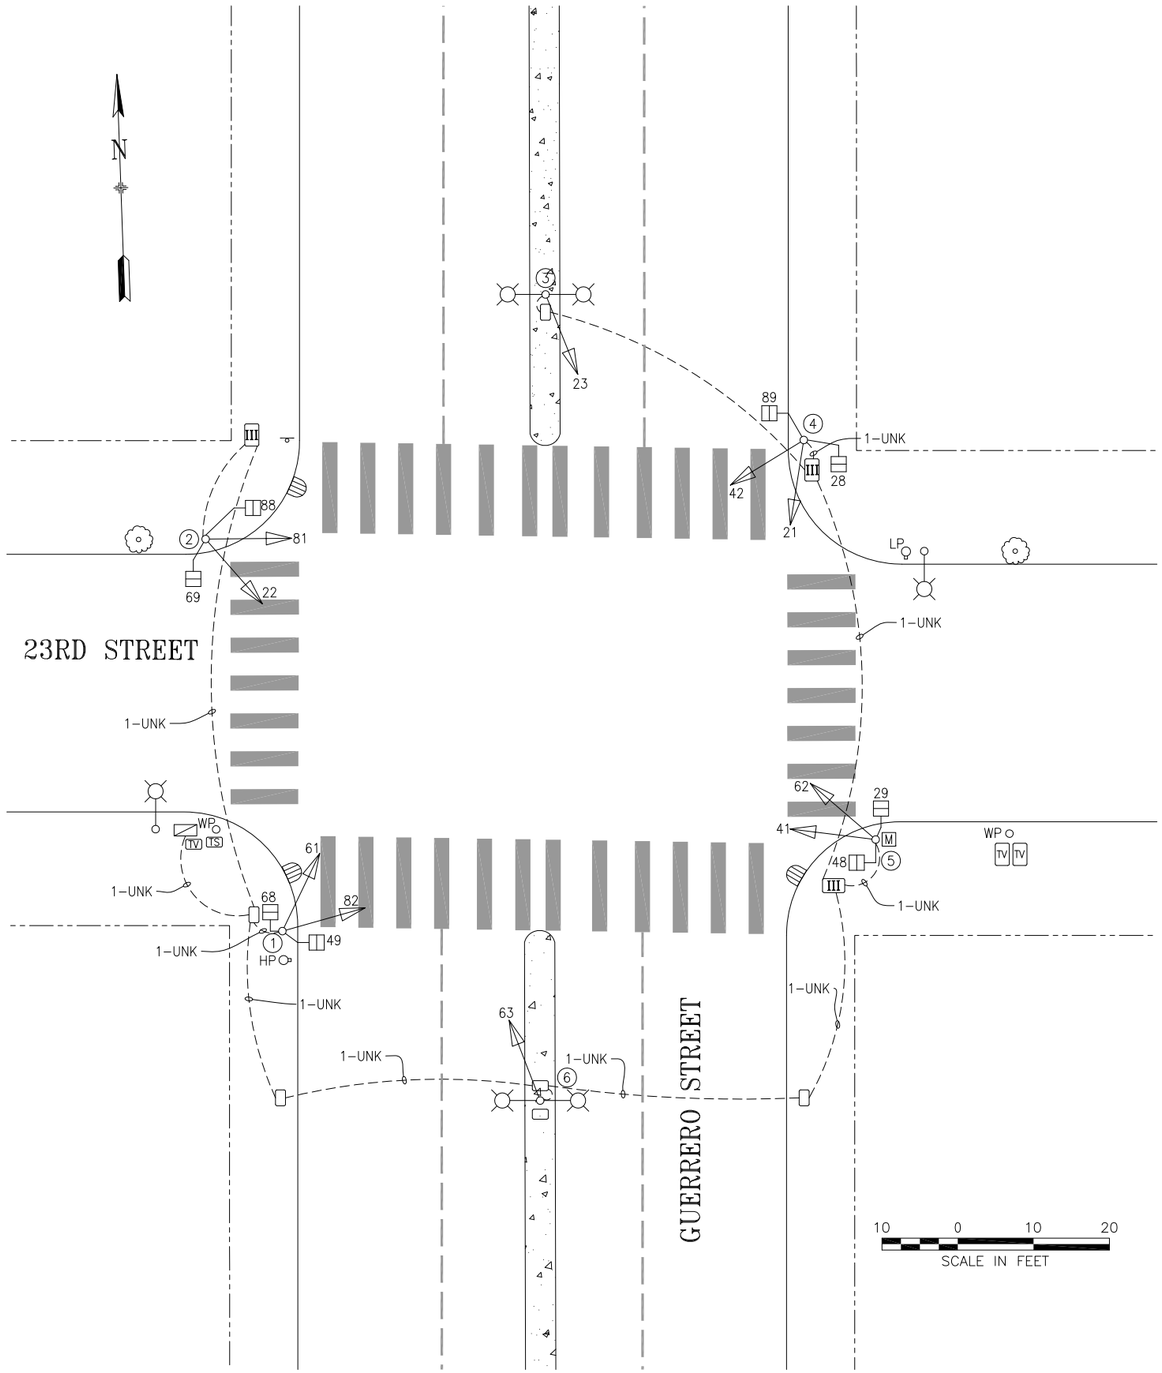

POLE AND EQUIPMENT SCHEDULE

POLE No.	TYPE OF POLE	LUMINAIRE VOLTAGE/ WATTAGE	VEHICLE SIGNAL					PEDESTRIAN SIGNAL			REMARKS
			No.	TYPE	MOUNTING	VISORS	LOUVERS	No.	TYPE	MOUNTING	
1	1-A (10')		61 82	3S12" 3S12"	TV-2-T-SFA	T T		49 68	1S-COUNT 1S-COUNT	SP-1 SP-1(22")	
2	1-A (10')		22 81	3S12" 3S12"	TV-2-T-SFA	T T		88 69	1S-COUNT 1S-COUNT	SP-1(22") SP-1-SF(12")	
3	STREET LIGHT W/DUAL LUMINAIRE ARMS		23	3S12"	SV-1	T					
4	PEDESTAL SIGNAL POLE		21 42	3S12" 3S12"	TV-2-T-SFA	T T		89 28	1S-COUNT 1S-COUNT	SP-1 SP-1(22")	
5	PEDESTAL SIGNAL POLE		41 62	3S12" 3S12"	TV-2-T-SFA	T T		48 29	1S-COUNT 1S-COUNT	SP-1(22") SP-1-SF(12")	
6	STREET LIGHT W/DUAL LUMINAIRE ARMS		63	3S12"	SV-1	T					

NO.	DATE	DESCRIPTION	BY	APP.
0	8/4/15	2543J PUNCHLIST WALKTHROUGH; ADD PCS AND UPGRADE TO 12"	DYeung	MVelasco

TABLE OF REVISIONS
CHECK WITH TRACING TO SEE IF YOU HAVE LATEST REVISION

REFERENCE INFORMATION & FILE NO. OF SURVEYS

SAN FRANCISCO MUNICIPAL TRANSPORTATION AGENCY
CITY AND COUNTY OF SAN FRANCISCO

DRAWN: AScales DATE: 11/2015
CHECKED: MVelasco DATE: 11/2015

SCALE: AS SHOWN
SHEET OF SHEETS 1 OF 1

TRAFFIC SIGNAL INVENTORY DIAGRAM
23RD STREET AND GUERRERO STREET

CNN NO. 25607000
REV NO. 0