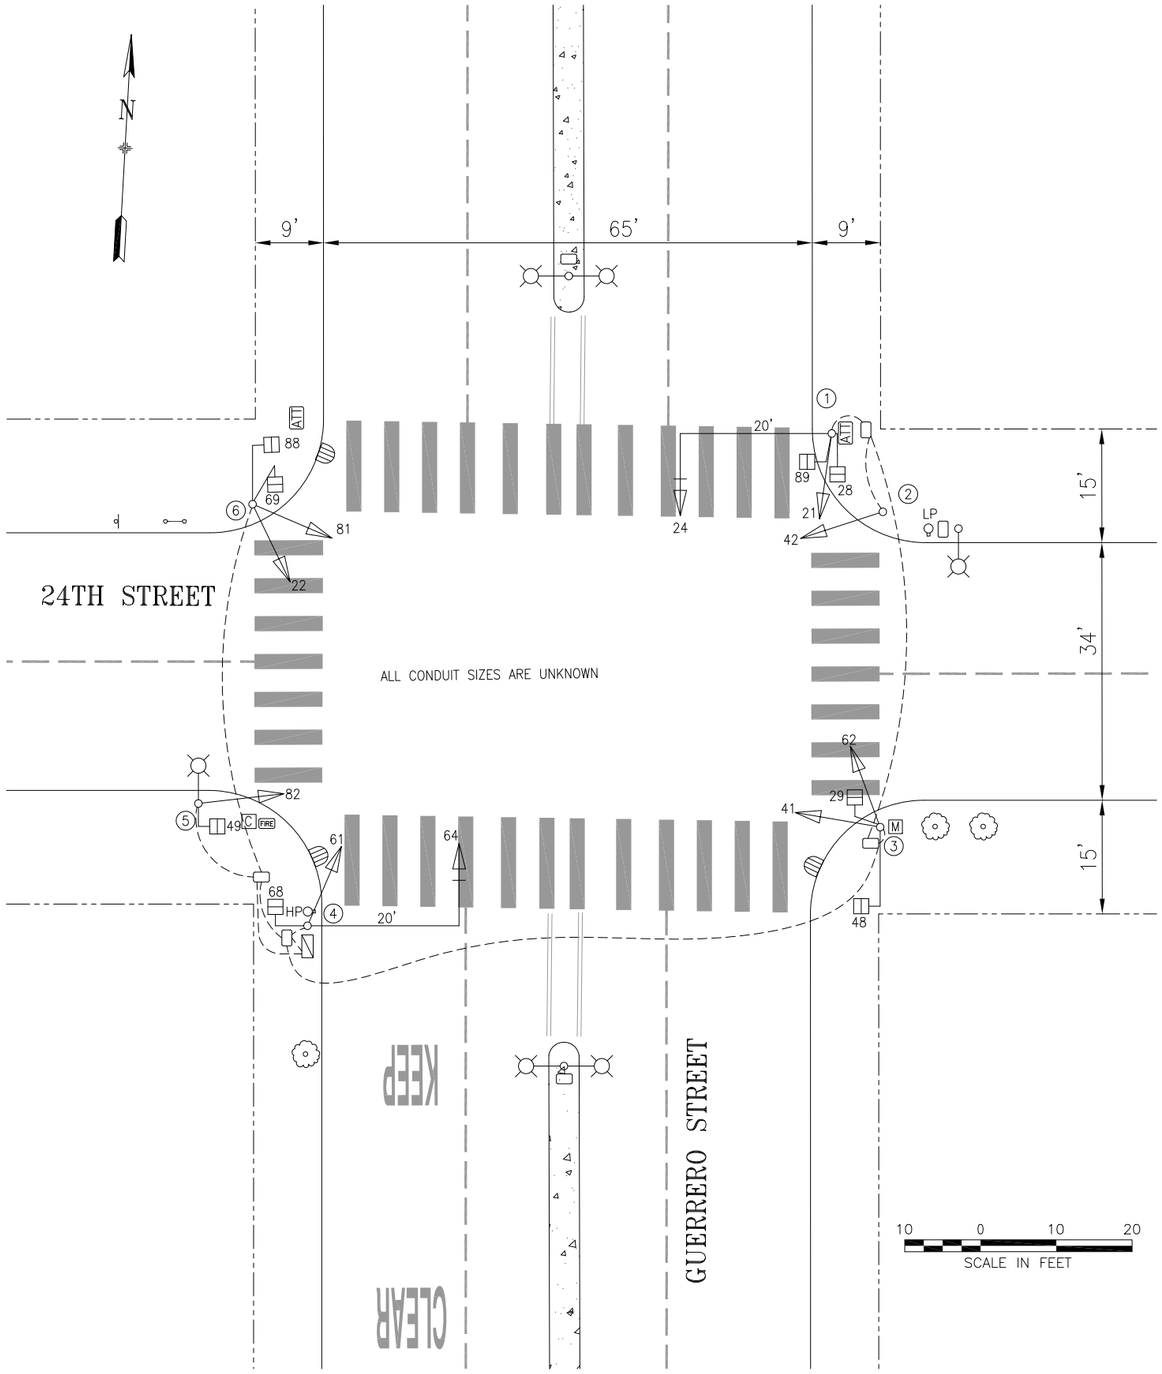

POLE AND EQUIPMENT SCHEDULE

POLE No.	TYPE OF POLE	LUMINAIRE VOLTAGE/ WATTAGE	VEHICLE SIGNAL					PEDESTRIAN SIGNAL			REMARKS
			No.	TYPE	MOUNTING	VISORS	LOUVERS	No.	TYPE	MOUNTING	
1	16-1-70 WITH 20' SIGNAL MAST ARM		24 21	PV3S12" 3S12"	MAS(TIP) SV-1-T	CAP T		89 28	1S-COUNT 1S-COUNT	SP-1-SF(12") SP-1(22")	BACKPLATE
2	1-A (10')		42	3S12"	TV-1-T	T					
3	PEDESTAL SIGNAL POLE (10')		41 62	3S12" 3S12"	TV-2-T-SFA	T T		48 29	1S-COUNT 1S-COUNT	SP-1(22") SP-1-SF(12")	
4	16-1-70 WITH 20' SIGNAL MAST ARM		64 61	3S12" 3S12"	MAS(TIP) SV-1-T	T T		68	1S-COUNT	SP-1	BACKPLATE
5	PEDESTAL STREET LIGHT POLE		82	3S12"	SV-1	T		49	1S-COUNT	SP-1	
6	PEDESTAL SIGNAL POLE (10')		22 81	3S12" 3S12"	TV-2-T-SFA	T T		88 69	1S-COUNT 1S-COUNT	SP-1(22") SP-1-SF(12")	

NO.	DATE	DESCRIPTION	BY	APPROVED
1	5/17/22	UPDATE PER FIELD: 24 IS PV WITH CAP VISOR. MINOR MOUNTING CLARIFICATIONS	DYeung	MVelasco
0	8/4/2015	2543J PUNCHLIST WALKTHROUGH	DYeung	MVelasco

TABLE OF REVISIONS
CHECKOUT DRAWING THROUGH THE SID CUSTODIAN FOR THE LATEST REVISION

SEAL OF THE CITY AND COUNTY OF SAN FRANCISCO

SFMTA

DRAWN BY: DYeung DATE: 9/2015
CHECKED BY: MVelasco DATE: 9/2015

SCALE: NONE
SHEET OF SHEETS: 1 OF 1

TRAFFIC SIGNAL INVENTORY DIAGRAM

24TH STREET AND GUERRERO STREET

CNN NO: 25603000
REV NO: 1