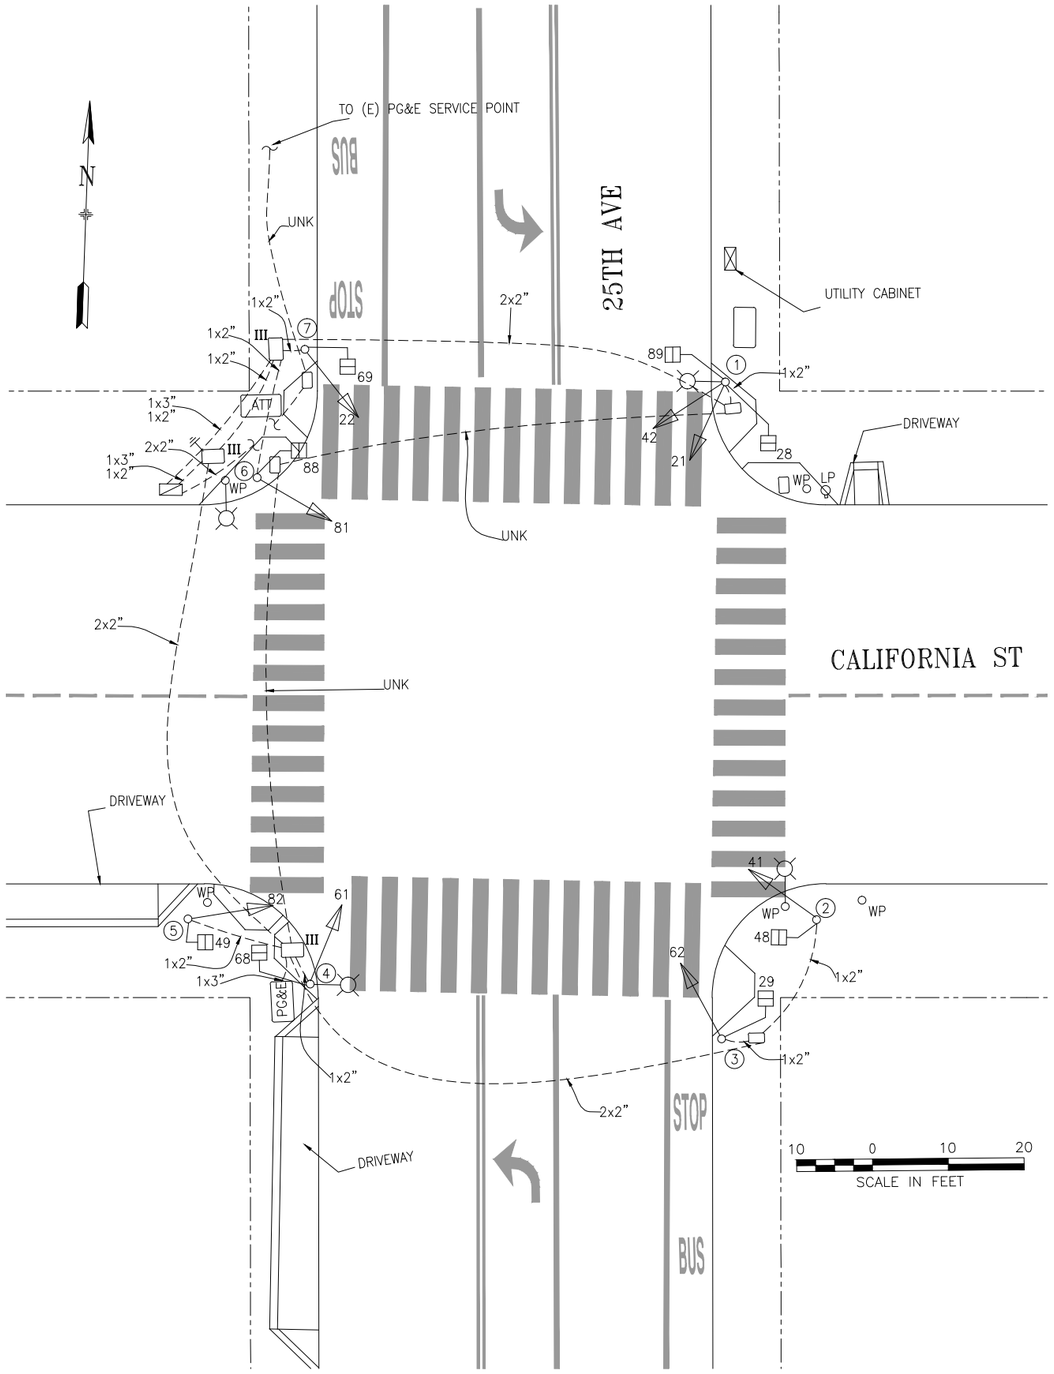

POLE AND EQUIPMENT SCHEDULE

POLE No.	TYPE OF POLE	VEHICLE SIGNAL					PEDESTRIAN SIGNAL			REMARKS
		No.	TYPE	MOUNTING	VISORS	LOUVERS	No.	TYPE	MOUNTING	
1	SL (MARBELITE)	42 21	3S12" 3S12"	SV-2-T-SF	T T		28 89	1S-COUNT 1S-COUNT	SP-1 (22'") SP-1-SF (12")	
2	1-A (10')	41	3S12"	TV-1-T	T		48	1S-COUNT	SP-1	
3	1-A (10')	62	3S12"	TV-1-T	T		29	1S-COUNT	SP-1	
4	SL (MARBELITE)	61	3S12"	SV-1-T	T		68	1S-COUNT	SP-1	
5	1-A (10')	82	3S12"	TV-1-T	T		49	1S-COUNT	SP-1	
6	MARBELITE (10')	81	3S12"	TV-1-T	T		88	1S-COUNT	SP-1	
7	1-A (10')	22	3S12"	TV-1-T	T		69	1S-COUNT	SP-1	

NO.	DATE	DESCRIPTION	BY	APP.
0	06/03/14	SIGNAL UPGRADE ACTIVATED THRU 1901J AND CONVERTED FROM AS-BUILTS	GD	MVelasco

TABLE OF REVISIONS
CHECK WITH TRACING TO SEE IF YOU HAVE LATEST REVISION

COMPLETION DATE / ELECTRICIAN INITIAL

SAN FRANCISCO MUNICIPAL TRANSPORTATION AGENCY
TRANSPORTATION ENGINEERING
CITY AND COUNTY OF SAN FRANCISCO

DRAWN: AScales DATE: 07/06/2015
CHECKED: MVelasco DATE: 07/2015
SCALE: AS SHOWN
SHEET OF SHEETS 1 OF 1

TRAFFIC SIGNAL INVENTORY DIAGRAM
25th AVENUE AND CALIFORNIA STREET

CNN NO. 27653000
REV. NO. 0