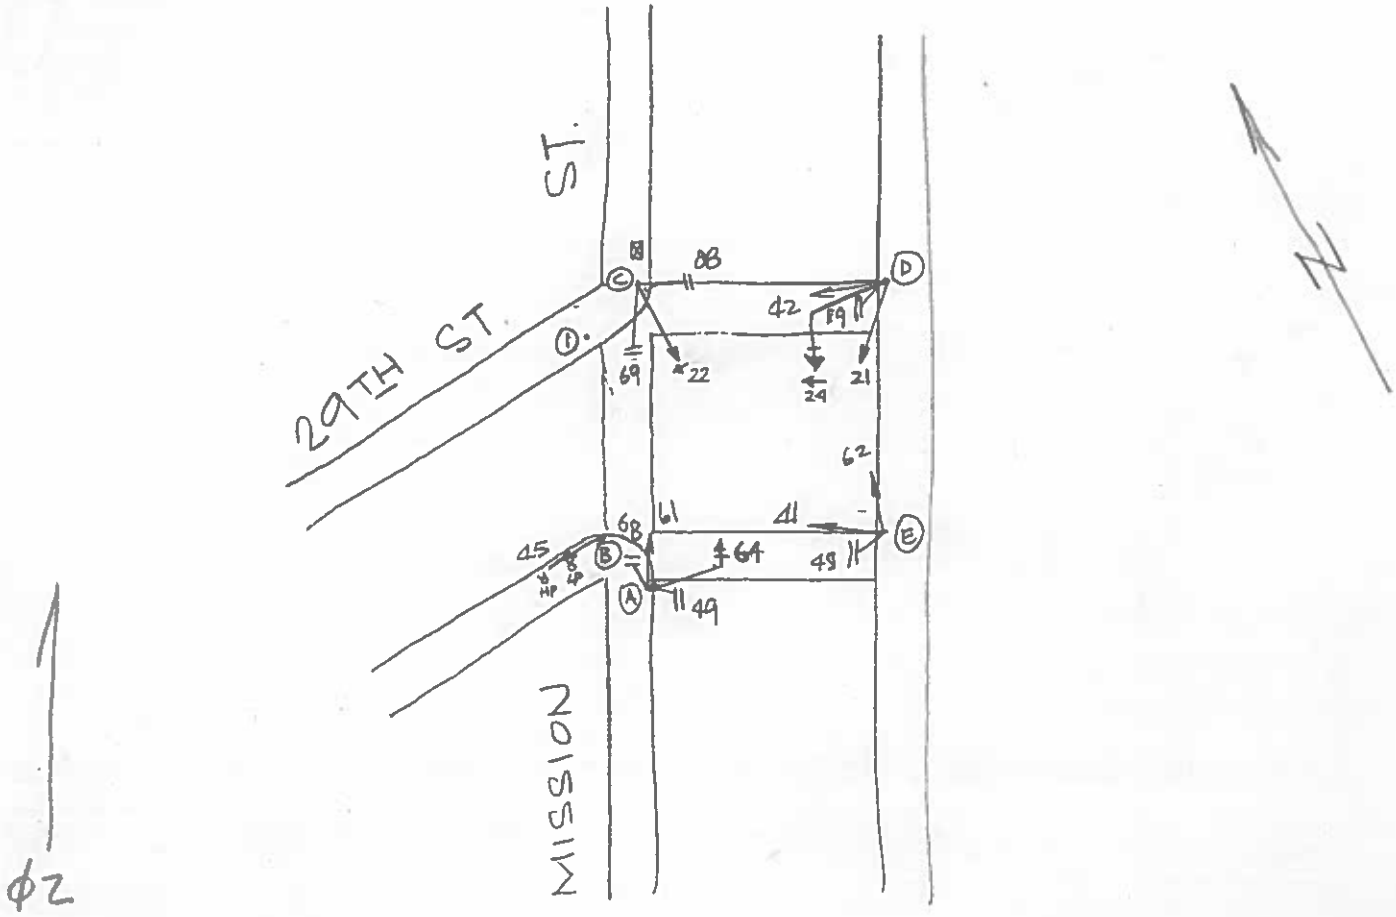

SRC changes implemented on 6/2/16

POLE	FUNC.	MAT'L
A	S	S
B	S	S
C	S	S
D	S	S
E	S	S
1	L	S

SIGNAL NO.	MAKE	NO. OF SECT.	SIZE	VISOR	B.P. OR LOUVERS	MOUN'T
61	EH	3	8"	T8"	NO	S
45	TCT	3	8"	T8"	No	S
22	CH	4	12"	T12"	NO.	T
42	CH	3	8"	T8"	NO	S
24	CH	4	12"	T12"	BP	A
62	CH	3	8"	T8"	NO	T
41	CH	3	8"	T8"	NO	T
21	CH	3	8"	T8"	NO	S
64	CH	3	12"	T12"	BP	A

PED SIGNAL NO.	LEGEND	MESSAGE ELEMENT	MESSAGE COLOR	MAKE	MOUN'T
49	I	15-I	W/OR	ICC	S
88	I	15-I	W/OR	ICC	S
89	I	15-I	W/OR	ICC	S
48	I	15-I	W/OR	ICC	S
68	I	I5-1	W/OR	ICC	S
69	I	I5-1	W/OR	ICC	S

CONTROLLER CABINET SIZE : ORDINARY BASE CABINET: Yes

COMMENTS : SRC 2016-118: Add left turn arrows to signals 22 & 24