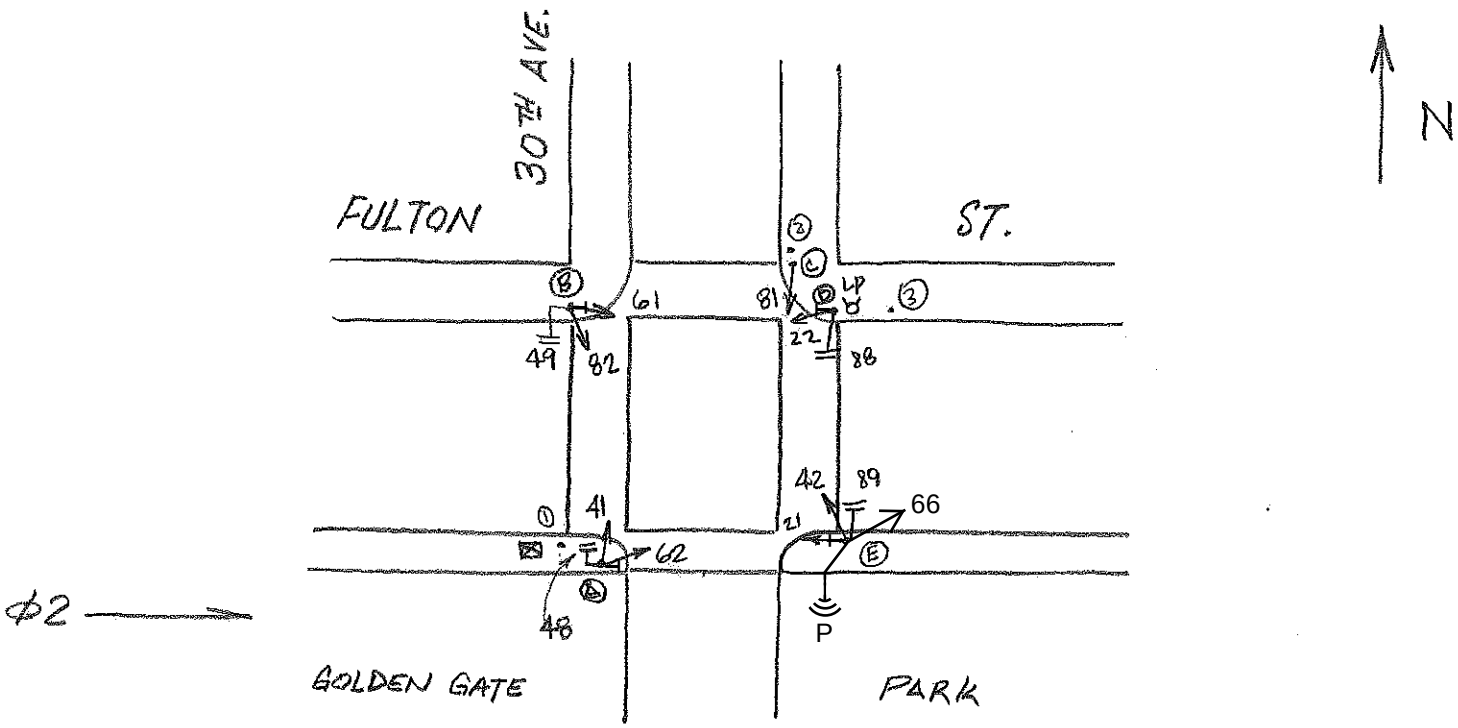

AS OF 01-24-2023

POLE	FUNC.	MAT'L
A	U	W
B	M	S
C	S	C
D	S	C
E	S	C
1	L	W
2	U	W
3	U	W

SIGNAL NO.	MAKE	NO. OF SECT.	SIZE	VISOR	B.P. OR LOUVERS	MOUN'T
41	EC	3	12"	T	NO	S
62	EC	3	12"	T	NO	S
82	EC	3	12"	T	NO	T
61	EC	3	12"	T	NO	T
81	EC	3	12"	T	NO	T
22	EC	3	12"	T	NO	T
21	EC	3	12"	T	NO	T
42	EC	3	12"	T	NO	T
66	EC	3	12"	T	NO	T

PED SIGNAL NO.	LEGEND	MESSAGE ELEMENT	MESSAGE COLOR	MAKE	MOUN'T
48	I	1S-I	W/OR	ICC	S
49	I	1S-I	W/OR	ICC	S
88	I	1S-I	W/OR	ICC	S
89	I	1S-I	W/OR	ICC	S

CONTROLLER CABINET SIZE: ORDINARY BASE CABINET: YES

COMMENTS: PER FIELD: ADD TSP/PREEMPTION EQUIPMENT TO POLE E AND PPB XING FULTON.
PER SRC 2022-236: ADD SIGNAL 66 TO POLE E.
E. Tang 01-24-2023.