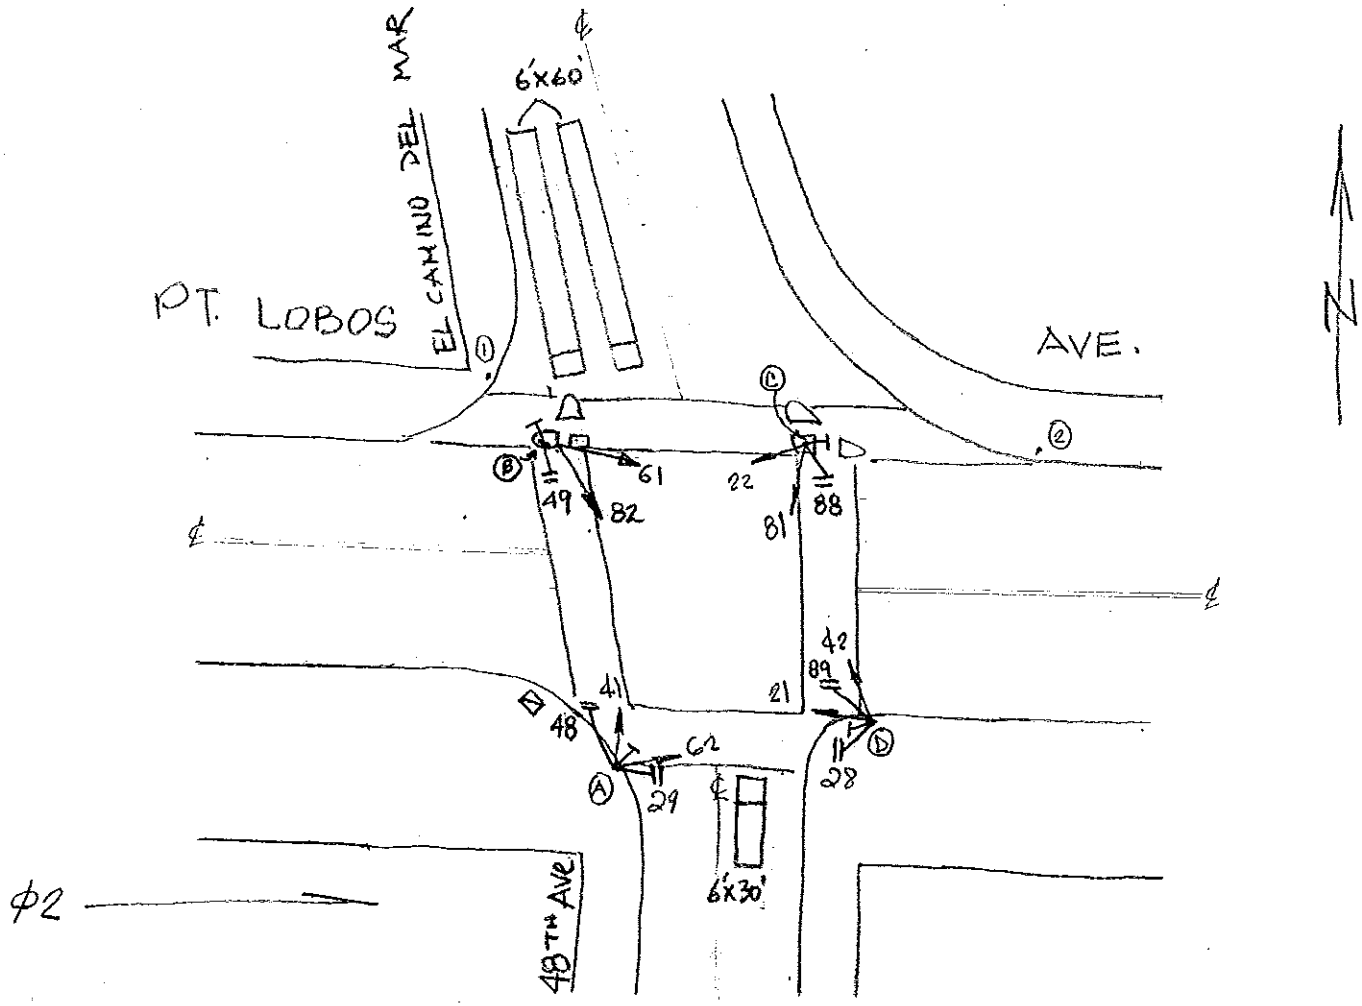

7-06-04

POLE	FUNC.	MAT'L
A	S	C
B	S	S
C	S	C
D	L	C
1	L	C
2	U	W

SIGNAL NO.	MAKE	NO. OF SECT.	SIZE	VISOR	B.P. OR LOUVERS	MOUN'T
62	EO	3	8"	FC 8"	No	T
41	EO	3	8"	FC 8"	No	T
82	ICC	3	8"	T 8"	No	T
61	ICC	3	8"	T 8"	No	T
22	EO	3	8"	FC 8"	No	T
81	EO	3	8"	FC 8"	No	T
42	EO	3	8"	FC 8"	No	S
21	EO	3	8"	FC 8"	No	S

PED SIGNAL NO.	LEGEND	MESSAGE ELEMENT	MESSAGE COLOR	MAKE	MOUN'T
48	I	IS-I	O/W	ICC	S
49	I	IS-I	O/W	ICC	S
88	I	IS-I	O/W	ICC	S
89	I	IS-I	O/W	ICC	S
28	COUNT	LED	O/W	Delight	S
29	COUNT	LED	O/W	Delight	S