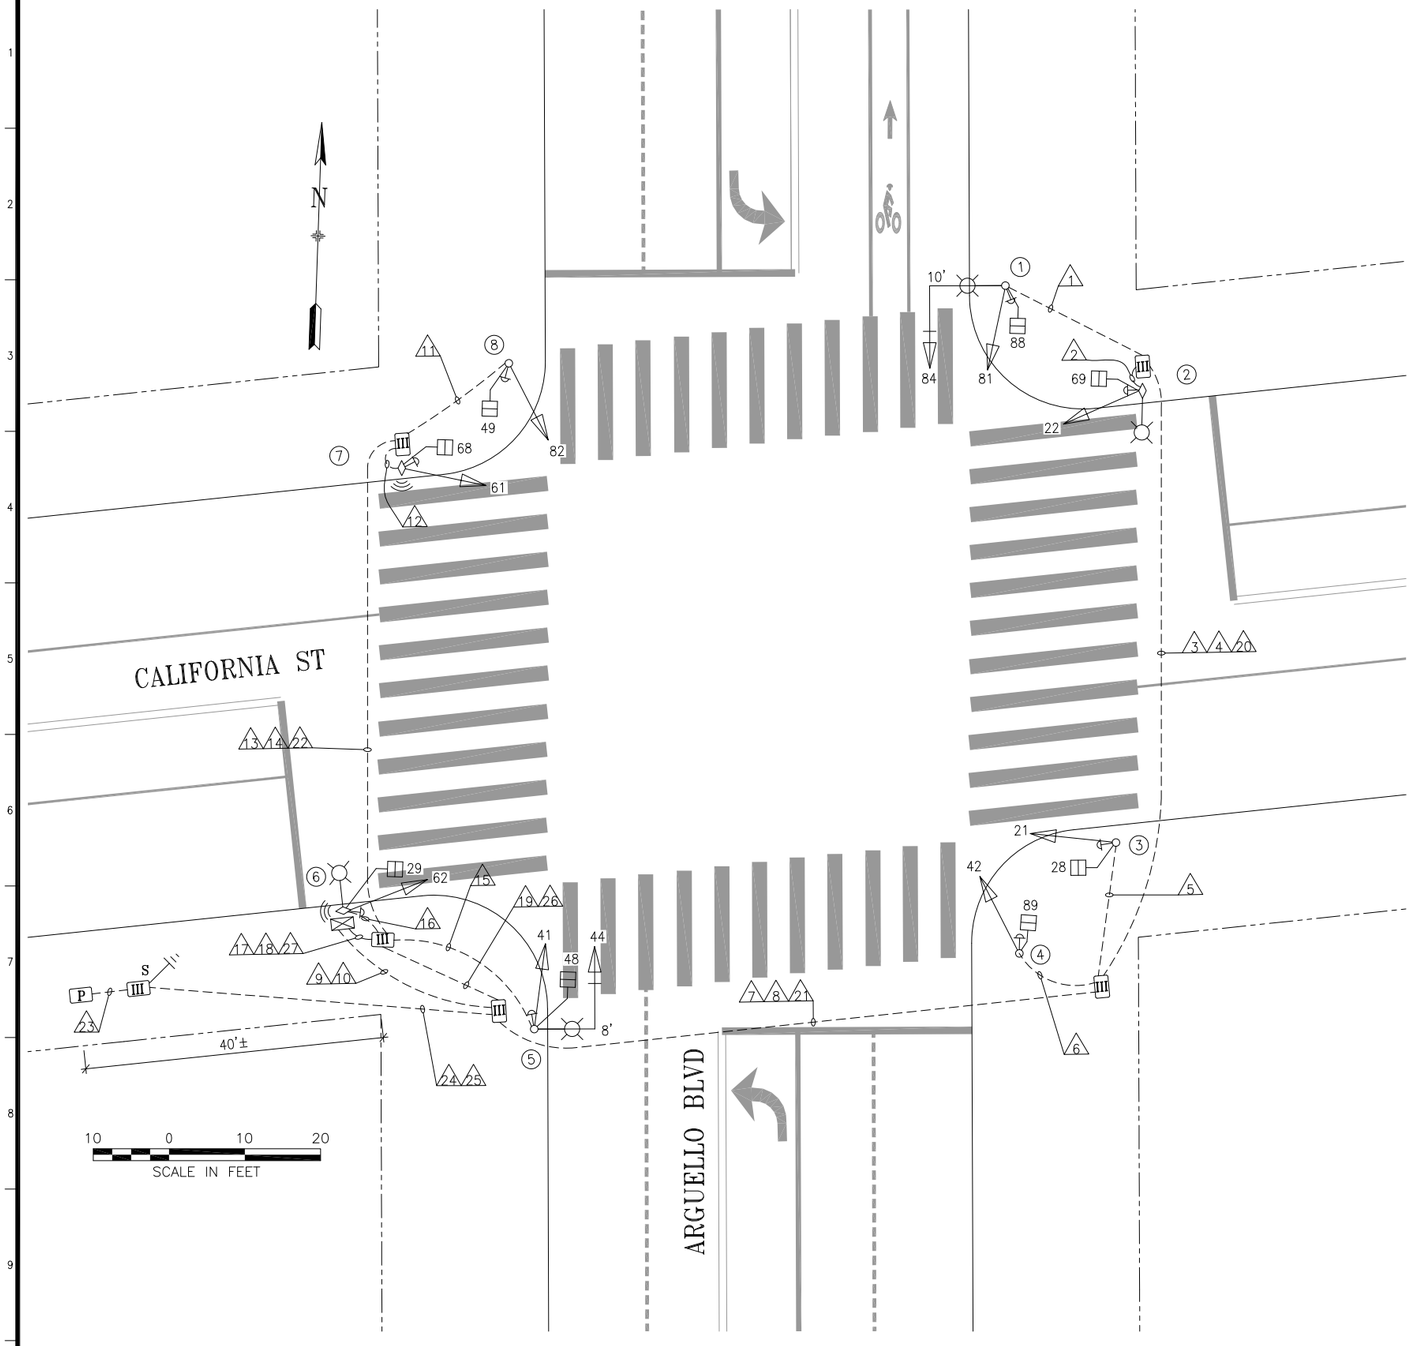

POLE AND EQUIPMENT SCHEDULE

POLE No.	TYPE OF POLE	LUMINARE TYPE	VEHICLE SIGNAL					PEDESTRIAN SIGNAL			REMARKS
			No.	TYPE	MOUNTING	VISORS	LOUVERS/BP	No.	TYPE	MOUNTING	
①	17-2-100 W/ 10' MAST ARM AND 6' LA	108W LED	81 84	3S12" 3S12"	SV-1-T MAS	T T	BP	88	1S-COUNT	SP-1	84 – PLUMBIZER MOUNT BTWN Y&G APS-2W
②	MUNI POLE WITH 6' LUMINAIRE ARM	LED	22	3S12"	SV-1-T	T		69	1S-COUNT	SP-1	APS-2W
③	1-A (10')		21	3S12"	TV-1-T	T		28	1S-COUNT	SP-1	APS-2W
④	1-A (10')		42	3S12"	TV-1-T	T		89	1S-COUNT	SP-1	APS-2W
⑤	17-2-100 W/ 8' MAST ARM AND 6' LA	108W LED	41 44	3S12" 3S12"	SV-1-T MAS	T T	BP	48	1S-COUNT	SP-1	44 – PLUMBIZER MOUNT BTWN Y&G APS-2W
⑥	MUNI POLE WITH 6' LUMINAIRE ARM	LED	62	3S12"	SV-1	T		29	1S-COUNT	SP-1	TSP EQUIPMENT APS-2W
⑦	MUNI POLE		61	3S12"	SV-1	T		68	1S-COUNT	SP-1	TSP EQUIPMENT APS-2W
⑧	1-A (10')		82	3S12"	TV-1-T	T		49	1S-COUNT	SP-1	APS-2W

NO.	DATE	DESCRIPTION	BY	APP.
1	01/21/21	ADD APS PER SRC 2020-198	E.LUU	G.DELEON
0	12/05/19	ARGUELLO SIGNAL UPGRADE, CONVERTED FROM CP AND AB	E.LUU	G.DELEON

TABLE OF REVISIONS
CHECK WITH TRACING TO SEE IF YOU HAVE LATEST REVISION

REFERENCE INFORMATION & FILE NO. OF SURVEYS

SAN FRANCISCO MUNICIPAL TRANSPORTATION AGENCY
CITY AND COUNTY OF SAN FRANCISCO

E.LUU 02/2020
DRAWN: E.LUU DATE: 02/2020
CHECKED: G.DELEON DATE: 02/2020

SCALE: AS SHOWN
SHEET OF SHEETS 1 OF 2

TRAFFIC SIGNAL INVENTORY DIAGRAM
ARGUELLO BOULEVARD AND CALIFORNIA STREET

CNN NO. 27566000
REV NO. 1

CONDUIT AND WIRING SCHEDULE

CONDUIT RUN NUMBER	1	2	3	4	5	6	7	8	9	10	11	12	13	14	15	16	17	18	19	20	21	22	23	24	25	26	27
CONDUIT SIZE (INCH)	2	2	2	2	2	2	2	2	3	2	2	2	2	2	2	2	3	2	2	2	2	2	3	2	2	2	UNK
NOTES	GRS	GRS		SP				SP				GRS		SP	GRS	GRS		SP	SP	GRS	GRS	GRS			GRS	GRS	
VEHICLE SIGNAL 81	UNKNOWN CONDUIT & WIRING SCHEDULE																										
VEHICLE SIGNAL 84	3		3				3		3																		
PED SIGNAL 88	UNKNOWN CONDUIT & WIRING SCHEDULE																										
APS PPB XING ARGUELLO ON POLE 1	2		2				2		2																		
VEHICLE SIGNAL 22	UNKNOWN CONDUIT & WIRING SCHEDULE																										
PED SIGNAL 69	UNKNOWN CONDUIT & WIRING SCHEDULE																										
APS PPB XING CALIFORNIA ON POLE 2		2	2				2		2																		
VEHICLE SIGNAL 21	UNKNOWN CONDUIT & WIRING SCHEDULE																										
PED SIGNAL 28	UNKNOWN CONDUIT & WIRING SCHEDULE																										
APS PPB XING CALIFORNIA ON POLE 3					2		2		2																		
VEHICLE SIGNAL 42	UNKNOWN CONDUIT & WIRING SCHEDULE																										
PED SIGNAL 89	UNKNOWN CONDUIT & WIRING SCHEDULE																										
APS PPB XING ARGUELLO ON POLE 4						2	2		2																		
VEHICLE SIGNAL 82	UNKNOWN CONDUIT & WIRING SCHEDULE																										
PED SIGNAL 49	UNKNOWN CONDUIT & WIRING SCHEDULE																										
APS PPB XING ARGUELLO ON POLE 8											2		2				2										
VEHICLE SIGNAL 61	UNKNOWN CONDUIT & WIRING SCHEDULE																										
PED SIGNAL 68	UNKNOWN CONDUIT & WIRING SCHEDULE																										
APS PPB XING CALIFORNIA ON POLE 7												2	2				2										
VEHICLE SIGNAL 41	UNKNOWN CONDUIT & WIRING SCHEDULE																										
VEHICLE SIGNAL 44															3		3										
PED SIGNAL 88	UNKNOWN CONDUIT & WIRING SCHEDULE																										
APS PPB XING ARGUELLO ON POLE 5															2		2										
VEHICLE SIGNAL 62	UNKNOWN CONDUIT & WIRING SCHEDULE																										
PED SIGNAL 29	UNKNOWN CONDUIT & WIRING SCHEDULE																										
APS PPB XING CALIFORNIA ON POLE 6																2	2										
#14 NEUTRAL	1														1												
#14 SPARE			3				3		3				3				3										
TOTAL #14 WIRES	UNKNOWN CONDUIT & WIRING SCHEDULE																										
#10 WIRES NEUTRAL			1				1		1				1				1										
#10 WIRES STREET LIGHT	2	2													2	2											
#8 WIRES STREET LIGHT																				2	2				2	2	
#8 WIRES (120 V SERVICE)										2														2			
#8 WIRES (120/240 V SERVICE)																							3				

NO.	DATE	DESCRIPTION	BY	APP.
0	12/05/19	ARGUELLO SIGNAL UPGRADE, CONVERTED FROM CP AND AB	E.LUU	G.DELEON

TABLE OF REVISIONS
CHECK WITH TRACING TO SEE IF YOU HAVE LATEST REVISION

REFERENCE INFORMATION & FILE NO. OF SURVEYS

SAN FRANCISCO MUNICIPAL TRANSPORTATION AGENCY
CITY AND COUNTY OF SAN FRANCISCO

DRAWN: E.LUU DATE: 02/2020
CHECKED: G.DELEON DATE: 02/2020

SCALE: AS SHOWN
SHEET OF SHEETS: 2 OF 2

TRAFFIC SIGNAL INVENTORY DIAGRAM
ARGUELLO BOULEVARD AND CALIFORNIA STREET

CNN NO. 27566000
REV NO. 0