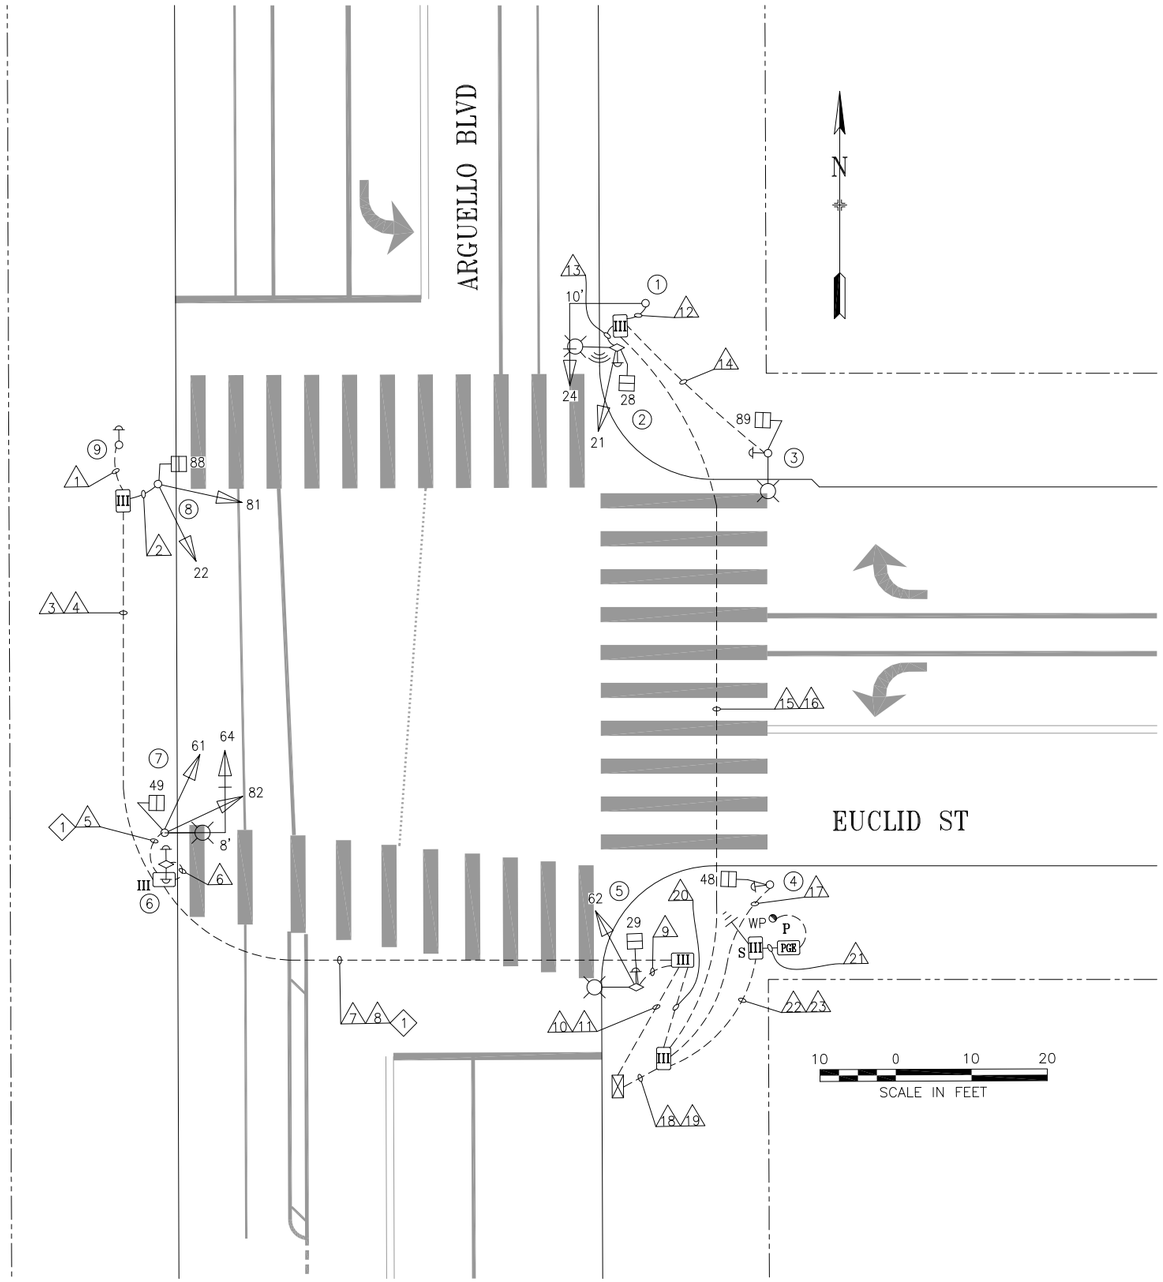

POLE AND EQUIPMENT SCHEDULE

POLE No.	TYPE OF POLE	LUMINAIRE TYPE	VEHICLE SIGNAL					PEDESTRIAN SIGNAL			REMARKS
			No.	TYPE	MOUNTING	VISORS	LOUVERS/BP	No.	TYPE	MOUNTING	
1	16-2-100 W/ 10' MAST ARM		24	3S12"	MAS	T					24 - PLUMBIZER MOUNT BTWN Y&G
2	MUNI POLE W/ 6' LA	LED	21	3S12"	SV-1-T	T		28	1S-COUNT	SP-1	APS-2W TSP EQUIPMENT
3	CITY STANDARD STREETLIGHT	145W LED						89	1S-COUNT	SP-1	APS-2W
4	1-A (7')							48	1S-COUNT	TP-1	APS-2W
5	EX. MUNI POLE W/ 6' LA	LED	62	3S12"	SV-1-T	T		29	1S-COUNT	SP-1-T	APS-2W
6	MUNI POLE										APS-2W x 2
7	17-2-100 W/ 8' MAST ARM AND 6' LA	145W LED	61 82 64	3S12" 3S12" 3S12"	SV-2-TA MAS	T T T	 BP	49	1S-COUNT	SP-1	64 - PLUMBIZER MOUNT BTWN Y&G
8	STEEL POLE		22 81	3S12" 3S12"	SV-2-TC	T T		88	1S-COUNT	SP-1	
9	PPB POLE										APS-2W

SHEET NOTES:

1. STREETLIGHT AND TRAFFIC SIGNAL SHARE GROUND WIRE

NO.	DATE	DESCRIPTION	BY	APP.
1	01/12/21	ADD APS PER SRC 2020-198. REMOVED OLD SERVICE WIRE.	E.LUU	G.DELEON
0	12/11/19	ARGUELLO SIGNAL UPGRADE, CONVERTED FROM CP AND AB	E.LUU	G.DELEON

TABLE OF REVISIONS
CHECK WITH TRACING TO SEE IF YOU HAVE LATEST REVISION

REFERENCE INFORMATION & FILE NO. OF SURVEYS

SAN FRANCISCO MUNICIPAL TRANSPORTATION AGENCY
CITY AND COUNTY OF SAN FRANCISCO

E.LUU 02/2020
DRAWN: E.LUU DATE: 02/2020
CHECKED: G.DELEON DATE: 02/2020

SCALE: AS SHOWN
SHEET OF SHEETS 1 OF 2

TRAFFIC SIGNAL INVENTORY DIAGRAM
ARGUELLO BOULEVARD AND EUCLID STREET

CNN NO. 27562000
REV NO. 1

CONDUIT AND WIRING SCHEDULE

CONDUIT RUN NUMBER	1	2	3	4	5	6	7	8	9	10	11	12	13	14	15	16	17	18	19	20	21	22	23
CONDUIT SIZE (INCH)	1	2	2	2	2	2	2	2	2	2	2	2	2	2	2	2	2	3	2	2	3	2	2
NOTES				SP	GRS	GRS		SP	GRS		SP		GRS	GRS									GRS
VEHICLE SIGNAL 22	UNKNOWN CONDUIT & WIRING SCHEDULE																						
VEHICLE SIGNAL 81	UNKNOWN CONDUIT & WIRING SCHEDULE																						
PED SIGNAL 88	UNKNOWN CONDUIT & WIRING SCHEDULE																						
APS PPB XING ARGUELLO ON POLE 9	2		2				2			2													
VEHICLE SIGNAL 61					3		3			3													
VEHICLE SIGNAL 64					3		3			3													
VEHICLE SIGNAL 82					3		3			3													
PED SIGNAL 49					2		2			2													
APS PPB XING ARGUELLO ON POLE 6						2	2			2													
VEHICLE SIGNAL 62	UNKNOWN CONDUIT & WIRING SCHEDULE																						
PED SIGNAL 29	UNKNOWN CONDUIT & WIRING SCHEDULE																						
APS PPB XING ARGUELLO ON POLE 5									2	2													
VEHICLE SIGNAL 24												3			3			3					
VEHICLE SIGNAL 21	UNKNOWN CONDUIT & WIRING SCHEDULE																						
PED SIGNAL 28	UNKNOWN CONDUIT & WIRING SCHEDULE																						
APS PPB XING ARGUELLO ON POLE 2													2		2			2					
PED SIGNAL 89														2	2			2					
APS PPB XING EUCLID ON POLE 3														2	2			2					
PED SIGNAL 48																	2	2					
APS PPB XING EUCLID ON POLE 4																	2	2					
#14 NEUTRAL					3							1		1			1						
#14 SPARE			3				3			3								3					
TOTAL #14 WIRES	UNKNOWN CONDUIT & WIRING SCHEDULE																5	18					
#10 WIRES NEUTRAL																							
#10 WIRES STREET LIGHT					2				2				2	2									
#8 WIRES STREET LIGHT							2								2					2			2
#8 WIRES (120 V SERVICE)																			2			2	
#8 WIRES (120/240 V SERVICE)																					3		

NO.	DATE	DESCRIPTION	BY	APP.
0	12/11/19	ARGUELLO SIGNAL UPGRADE, CONVERTED FROM CP AND AB	E.LUU	G.DELEON

TABLE OF REVISIONS
CHECK WITH TRACING TO SEE IF YOU HAVE LATEST REVISION

REFERENCE INFORMATION & FILE NO. OF SURVEYS

SAN FRANCISCO MUNICIPAL TRANSPORTATION AGENCY
CITY AND COUNTY OF SAN FRANCISCO

DRAWN: E.LUU DATE: 02/2020
CHECKED: G.DELEON DATE: 02/2020

SCALE: AS SHOWN
SHEET OF SHEETS: 2 OF 2

TRAFFIC SIGNAL INVENTORY DIAGRAM
ARGUELLO BOULEVARD AND EUCLID STREET

CNN NO. 27562000
REV NO. 0