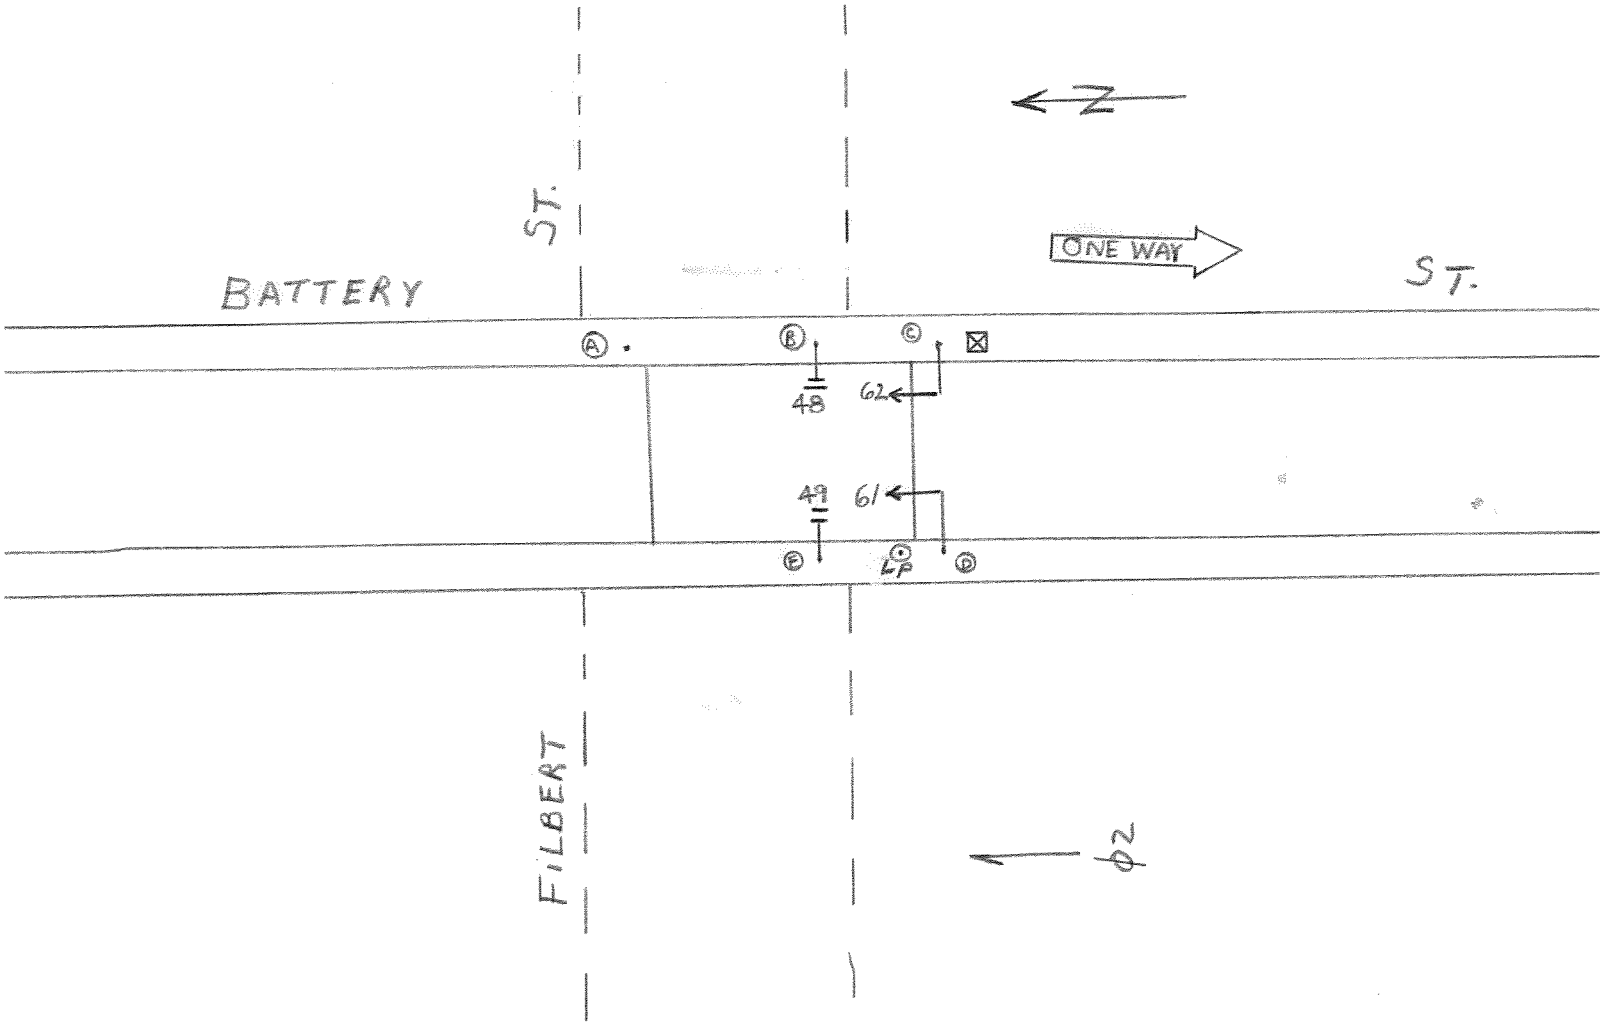

8-14-17

POLE	FUNC.	MAT'L
A	L	S
B	S	S
C	S	S
D	S	S
E	S	S

SIGNAL NO.	MAKE	NO. OF SECT.	SIZE	VISOR	B.P. OR LOUVERS	MOUN'T
61	PV	3	12"	FC12"	YES	T
62	PV	3	12"	FC12"	YES	T

PED SIGNAL NO.	LEGEND	MESSAGE ELEMENT	MESSAGE COLOR	MAKE	MOUN'T
48	W/DW	IS-I	W/OR	ICC	T
49	W/DW	IS-I	W/OR	ICC	T

CONTROLLER CABINET SIZE : ORDINARY BASE CABINET: YES

COMMENTS : SRC 2017-255

RENUMBERED PHASES TO MATCH TIMING CARD