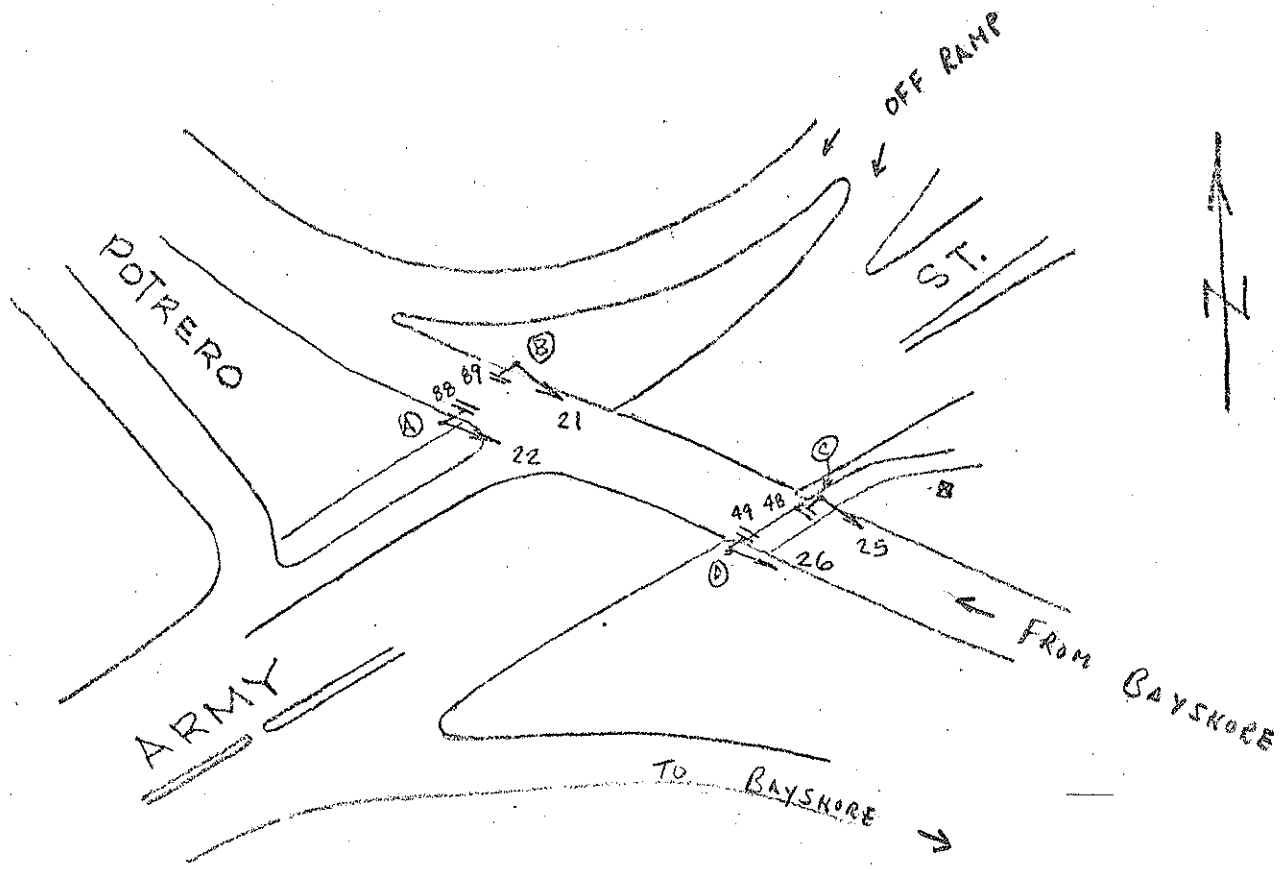

9-19-79

POLE	FUNC.	MAT'L
A	L	S
B	L	S
C	L	S
D	S	S

SIGNAL NO.	MAKE	NO. OF SECT.	SIZE	VISOR	B.P. OR LOUVERS	MOUN'T
22	A-1	3	8"	FC 8"	NO	S
21	A-1	3	8"	FC 8"	NO	S
25	A-1	3	8"	FC 8"	NO	S
26	EA	3	8"	FC 8"	NO	T

PED SIGNAL NO.	LEGEND	MESSAGE ELEMENT	MESSAGE COLOR	MAKE	MOUN'T
89	W/DW	GRD	W/OR	A-1	S
88	W/DW	GRD	W/OR	A-1	S
48	W/DW	GRD	W/OR	A-1	S
49	W/DW	GRD	W/OR	ED	S

CONTROLLER CABINET SIZE : ORDINARY BASE CABINET: YES

COMMENTS :