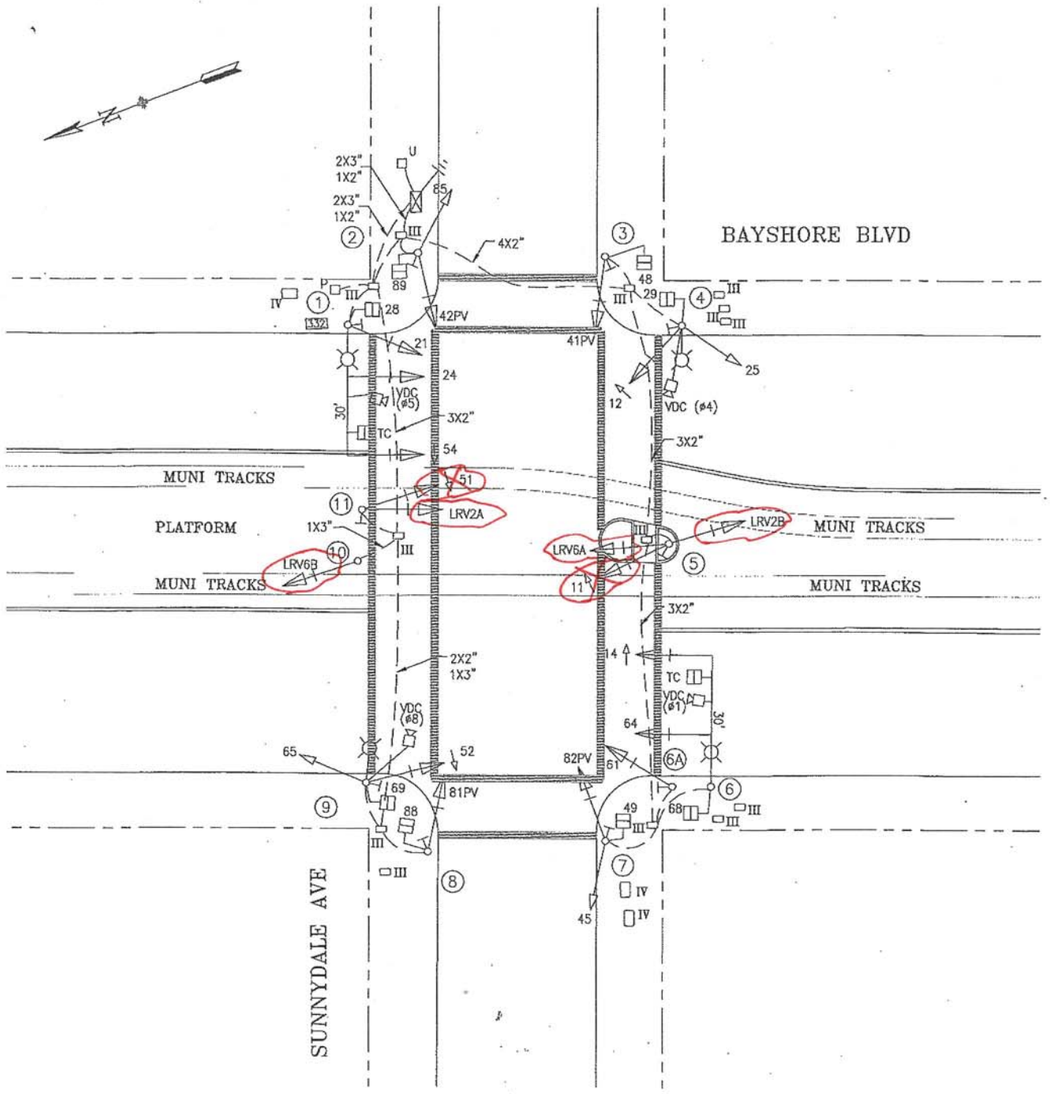

NOTE:

1. CABINET FOUNDATION TYPE: M-SF
2. SIGNALS SWITCHED OVER ON 6/22/04.
3. ALL PPB ARE THE ACCESSIBLE TYPE.

POLE AND EQUIPMENT SCHEDULE

POLE No.	TYPE OF POLE	LUMINAIRE (HPS) VOLTAGE/ WATTS	VEHICLE SIGNAL No.	VEHICLE SIGNAL TYPE	VEHICLE SIGNAL MOUNTING (F/I)	PEDESTRIAN SIGNAL No.	PEDESTRIAN SIGNAL TYPE	PEDESTRIAN SIGNAL MOUNTING (F/I)	REMARKS
1	MUNI COMBO POLE (TYPE 767) WITH 30' M.A. & LUMINAIRE ARM		21 24 TC 54	3S12" 3S12" IS 16" x 16" 3S12" LA	SV-1-T MAS MAT MAS	28	1S-COUNT	SP-1	VDC (#5 BAYSHORE NBLT) PPB BACKPLATE BACKPLATE BACKPLATE
2	1-A (10')		42 85	3S12"PV 3S8"	TV-2-T	89	1S-COUNT	SP-1	PPB BACKPLATE
3	1-A (10')		41	3S12"PV	TV-1-T	48	1S-COUNT	SP-1	PPB BACKPLATE
4	MUNI COMBO POLE (TYPE 770) WITH LUMINAIRE ARM		12 25	3S12" LA 3S8"	SV-2-T	29	1S-COUNT	SP-1	VDC (#4 SUNNYDALE EB) PPB BACKPLATE
5	1-A (15') 2S12"LB-1		~~11~~ LRV2B LRV6A	~~3S12" LA~~ ~~2S12" T~~ ~~2S12" T~~	~~SV-1-T~~ TV-2-T				PPB BACKPLATE BACKPLATE BACKPLATE
6	MUNI COMBO POLE (TYPE 770) WITH 30' M.A. & LUMINAIRE ARM		14 64 TC	3S12" LA 3S12" IS 16" x 16"	MAS MAS MAT				VDC (#1 BAYSHORE SBLT) BACKPLATE BACKPLATE
6A	1-A (10')		61	3S12"	TV-1-T	68	1S-COUNT	SP-1	PPB BACKPLATE
7	1-A (10')		45 82	3S8" 3S12"PV	TV-2-T	49	1S-COUNT	SP-1	PPB BACKPLATE
8	1-A (10')		81	3S12"PV	TV-1-T	88	1S-COUNT	SP-1	PPB BACKPLATE
9	MUNI COMBO POLE (TYPE 770) WITH LUMINAIRE ARM		52 65	3S12"LA 3S8"	SV-2-T	69	1S-COUNT	SP-1	VDC (#8 SUNNYDALE WB) PPB BACKPLATE
10	1-A (12') 2S12"LB-1		LRV6B	~~2S12" T~~	TV-1-T				BACKPLATE
11	1-A (15')		LRV2A ~~51~~	~~2S12" T~~ ~~3S12" LA~~	TV-1-T ~~SV-1-T~~				PPB BACKPLATE BACKPLATE

M.A. = MAST ARM

5 0 10 20
(IN METERS)

NO.	DATE	DESCRIPTION	BY	APP.
2	1/5/14	RED MARK CHANGES PER SRC 2013-327	BW	CW
1	6/23/08	PER FIELD CHECK 6/23/08	DY	AH
1	6/22/04	TRAFFIC SIGNAL UPGRADE FOR THIRD ST. LIGHT RAIL	KK	AH

TABLE OF REVISIONS
CHECK WITH TRACING TO SEE IF YOU HAVE LATEST REVISION

COMPLETION DATE / ELECTRICIAN INITIAL

DEPARTMENT OF PARKING AND TRAFFIC
DIVISION OF TRAFFIC ENGINEERING
CITY AND COUNTY OF SAN FRANCISCO

DRAWN: KK	DATE: 9/05	SCALE: 1:200	TRAFFIC SIGNAL INVENTORY DIAGRAM	CNN NO. 20306000
CHECKED:	DATE:	SHEET OF SHEETS 1 OF 1	BAYSHORE AND SUNNYDALE	REV. NO. X 2