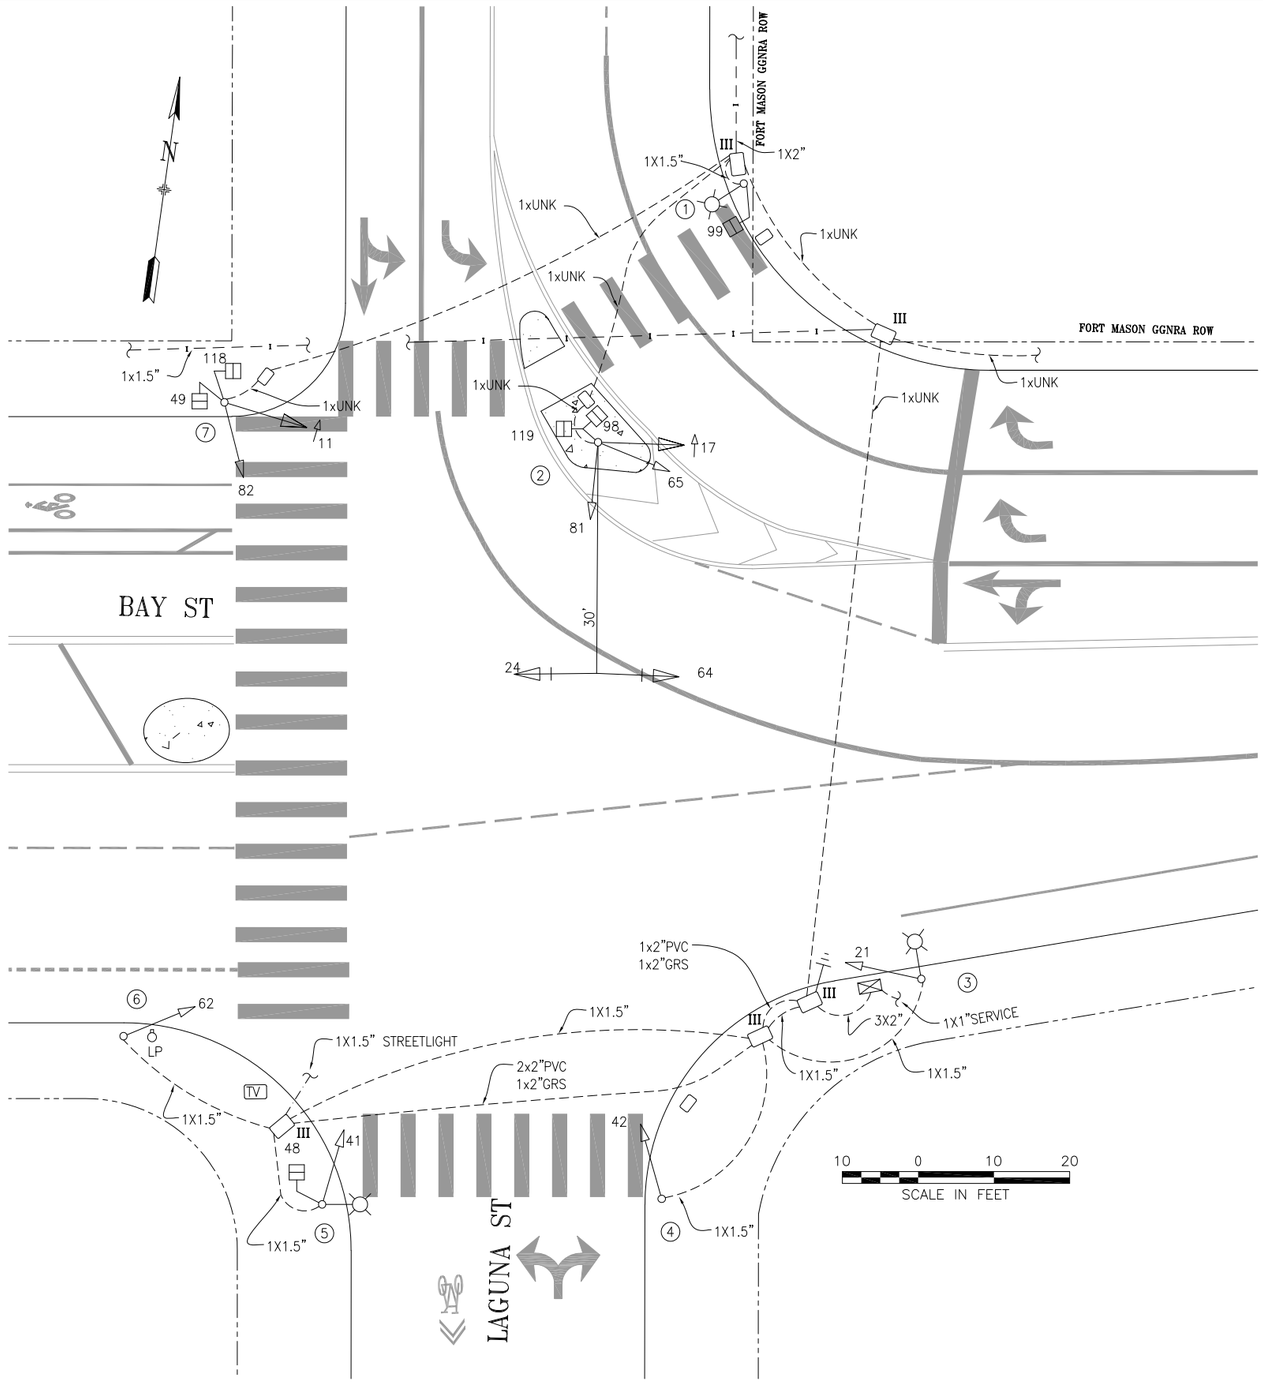

POLE AND EQUIPMENT SCHEDULE

POLE No.	TYPE OF POLE	LUMINAIRE VOLTAGE/ WATTAGE	VEHICLE SIGNAL					PEDESTRIAN SIGNAL			REMARKS
			No.	TYPE	MOUNTING	VISORS	LOUVERS/BP	No.	TYPE	MOUNTING	
1	MARBELITE SL							99	1S-COUNT	SP-1	
2	SIGNAL POLE W/ 30' MA		65 17 81 24 64	3S8" 3S12"RA 4S**" 3S12" 3S12"	SV-1 SV-2-TA MAT MAT	FC FC FC T T	BP BP	98 119	1S-COUNT 1S-COUNT	SP-2-T	
3	MARBELITE SL		21	3S8"	SV-1-T	FC					
4	MARBELITE(10')		42	4S 8"R,Y,G 12"GLA	TV-1	T(8") CAP(12")					
5	MARBELITE SL		41	4S 8"R,Y,G 12"GLA	SV-1-T	T(8") CAP(12")		48	1S-COUNT	SP-1	
6	MARBELITE(10')		62	3S8"	TV-1	FC					
7	MARBELITE SL		11 82	3S12"RA 4S 8"R,Y 12"GLA,GRA	SV-2-TA	FC FC		49 118	1S-COUNT 1S-COUNT	SP-1 SP-1	

4S**" = 4S
8"R,Y
12"GLA,GRA

NO.	DATE	DESCRIPTION	BY	APPROVED
0	6/10/21	PER PUNCHLIST, FIELD CONDITION, & CONVERTED FROM CONTRACT PLANS FOR 2937J	D. YEUNG	G. de LEON

TABLE OF REVISIONS
CHECKOUT DRAWING THROUGH THE SID CUSTODIAN FOR THE LATEST REVISION

SEAL OF THE CITY AND COUNTY OF SAN FRANCISCO

SFMTA

DRAWN BY: D. YEUNG DATE: JULY 2023
CHECKED BY: G. de LEON DATE: JULY 2023

SCALE: AS SHOWN
SHEET OF SHEETS: 1 OF 1

TRAFFIC SIGNAL INVENTORY DIAGRAM

BAY ST AND LAGUNA ST

CNN NO: 26754000
REV NO: 0