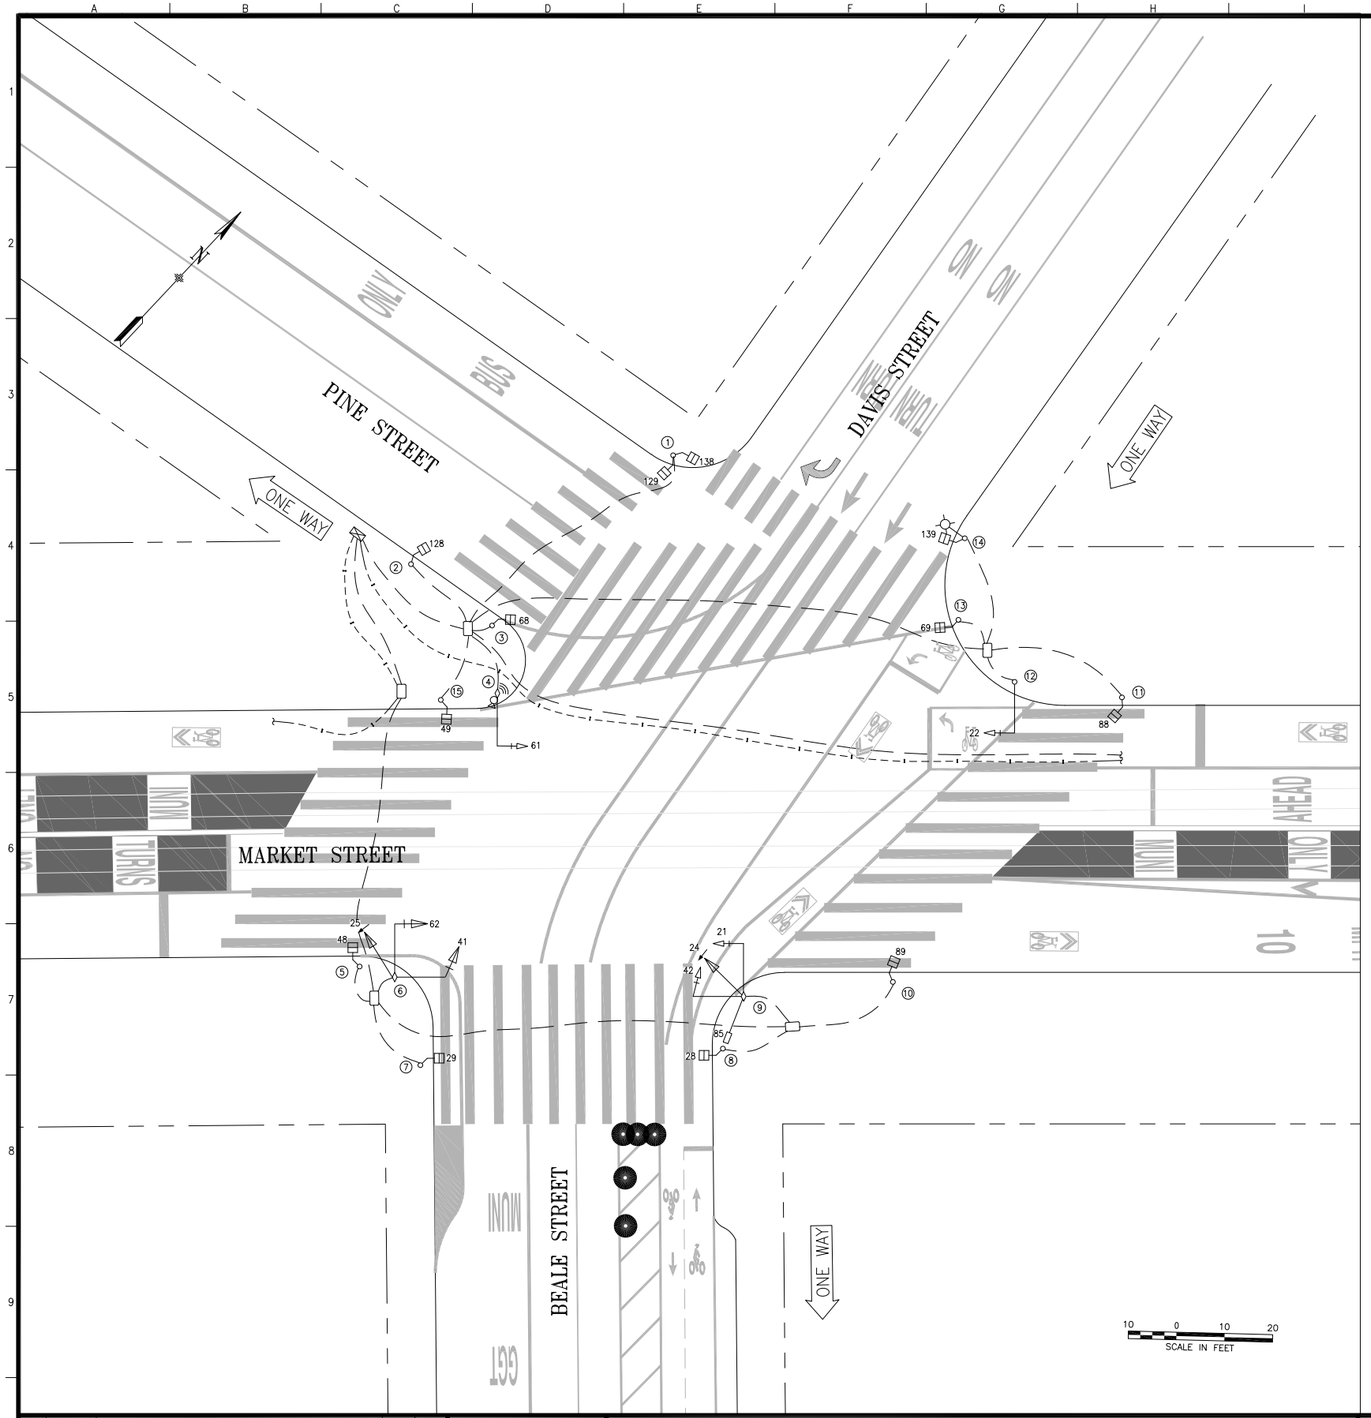

POLE AND EQUIPMENT SCHEDULE

POLE No.	TYPE OF POLE	LUMINAIRE VOLTAGE/ WATTAGE	VEHICLE SIGNAL					PEDESTRIAN SIGNAL			REMARKS
			No.	TYPE	MOUNTING	VISORS	LOUVERS	No.	TYPE	MOUNTING	
1	SL (DECORATIVE)							129 138	1S-COUNT 1S-COUNT	SP-2-T SP-2-T	
2	1-A (7')							128	1S-COUNT	TP-1	
3	1-A (7')							68	1S-COUNT	TP-1	
4	MARKET STREET POLE W/ MAST ARM		61	3S8"	MAS	FC					TSP EQUIPMENT SFGO CAMERA
5	1-A (7')							48	1S-COUNT	TP-1	
6	MARKET STREET POLE W/ 2 MAST ARMS		25 41 62	4S12"RA 3S12" 3S12"	SV-1-T MAS MAS	T T T					CIRCULAR BACKPLATE CIRCULAR BACKPLATE
7	1-A (7')							29	1S-COUNT	TP-1	
8	1-A (7')							28	1S-COUNT	TP-1	
9	MARKET STREET POLE W/ 2 MAST ARMS		24 21 42 85	4S12"RA 3S8" 3S8" 3S8"BIKE	SV-1-T MAS MAS SV-2-TA	T FC FC T					CIRCULAR BACKPLATE CIRCULAR BACKPLATE
10	1-A (7')							89	1S-COUNT	TP-1	
11	1-A (7')							88	1S-COUNT	TP-1	
12	MARKET STREET POLE W/ MAST ARM		22	3S8"	MAS	FC					CIRCULAR BACKPLATE
13	1-A (7')							69	1S-COUNT	TP-1	
14	SL							139	1S-COUNT	SP-1-T	
15	1-A (7')							49	1S-COUNT	TP-1	

NO.	DATE	DESCRIPTION	BY	APP.
6	12/28/20	CONVERT FROM MSID AND TRANSBAY TRANSIT CENTER TEMP TERMINAL CP.	E.CHEN	MS
		PER SRC 2020-327: SPLICED NEW 3S8" BIKE SIGNAL 85 TO SIGNAL 42 ON POLE 9.		

TABLE OF REVISIONS
CHECK WITH TRACING TO SEE IF YOU HAVE LATEST REVISION

REFERENCE INFORMATION & FILE NO. OF SURVEYS

SAN FRANCISCO MUNICIPAL TRANSPORTATION AGENCY
CITY AND COUNTY OF SAN FRANCISCO

DRAWN: E.CHEN DATE: 4/5/21
CHECKED: M.S. DATE: 4/5/21

SCALE: AS SHOWN
SHEET OF SHEETS 01 OF 01

TRAFFIC SIGNAL INVENTORY DIAGRAM

BEALE STREET, DAVIS STREET
MARKET STREET, AND PINE STREET

CNN NO. 30729000
REV NO. 0