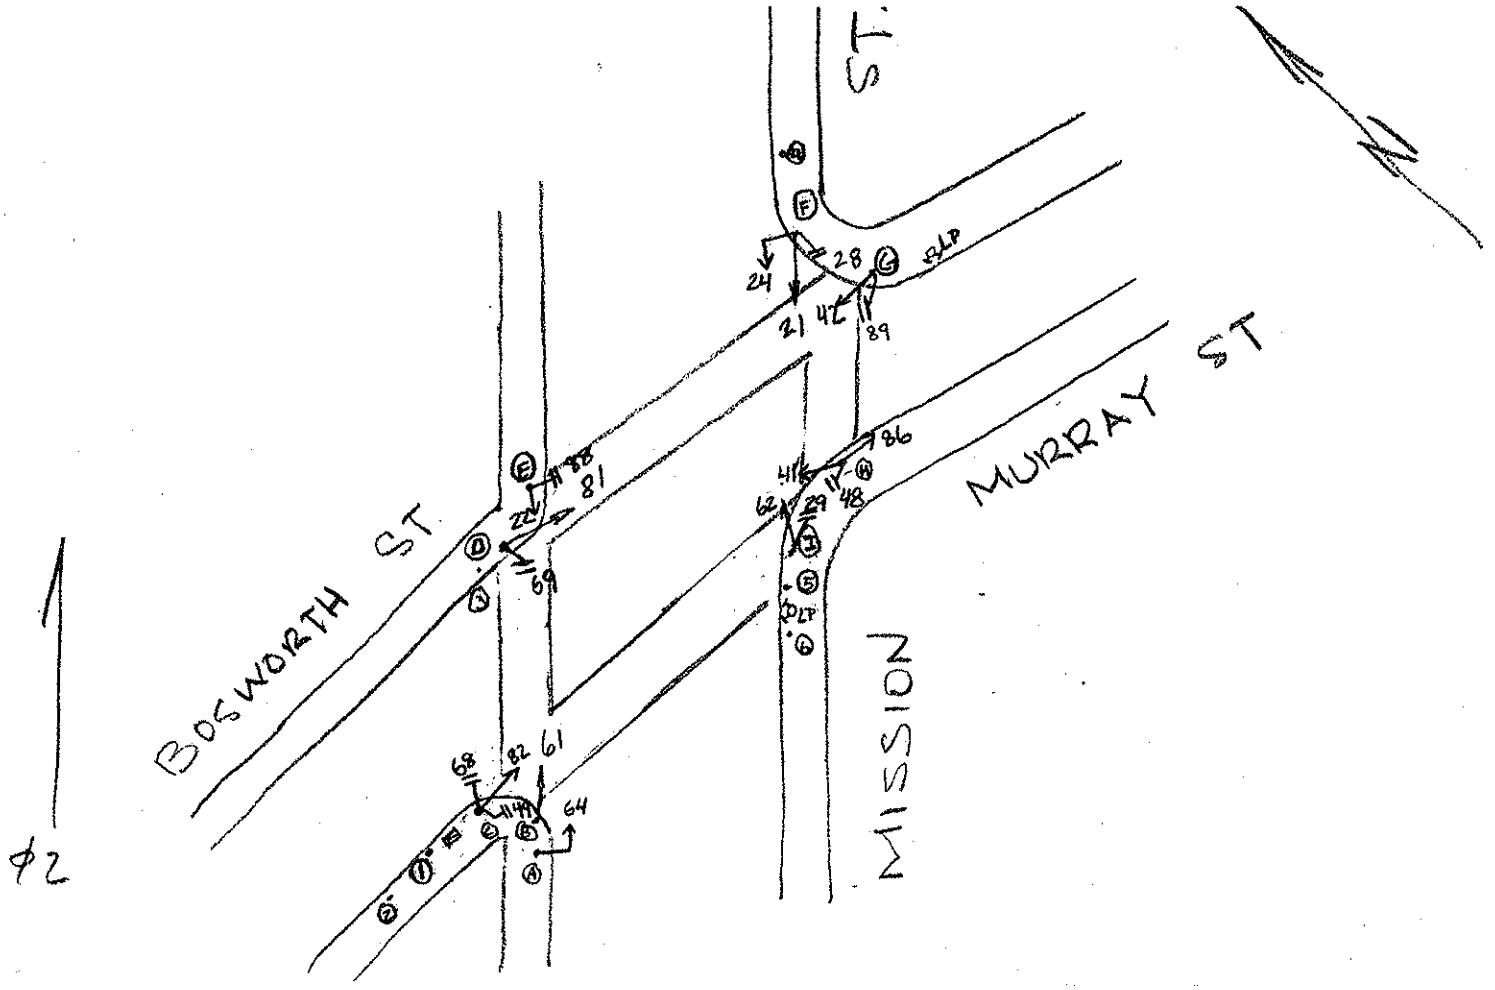

Signal Upgrade Switchover 3/23/00

POLE	FUNC.	MAT'L
A	S	S
B	M/L	S
C	S	S
D	S	S
E	S	S
F	S	S
G	S	S
H	L	S
I	S	S
1	U	W
2	U	W
3	M/L	S
4	M/L	S
5	U	W
6	M	S

SIGNAL NO.	MAKE	NO. OF SECT.	SIZE	VISOR	B.P. OR LOUVERS	MOUN'T
64	CH	3	12"	T	BP	MAS
61	CH	3	8"	RT	NO	S
82	CH	3	12"	LT	NO	T
81	CH	3	12"	T	NO	T
22	CH	3	8"	T	NO	T
24	CH	3	12"	RT	BP	MAS
21	CH	3	8"	RT	NO	S
42	CH	3	12"	LT	NO	T
41	CH	3	12"	T	NO	S
86	CH	3	8"	T	NO	S
62	CH	3	8"	T	NO	T

PED SIGNAL NO.	LEGEND	MESSAGE ELEMENT	MESSAGE COLOR	MAKE	MOUN'T
49	I	IS-I	W/OR	ICC	S
68	I	IS-I	W/OR	ICC	S
69	I	IS-I	W/OR	ICC	S
88	I	IS-I	W/OR	ICC	S
89	I	IS-I	W/OR	ICC	S
28	I	IS-I	W/OR	ICC	S
48	I	IS-I	W/OR	ICC	S
29	I	IS-I	W/OR	ICC	S

CONTROLLER CABINET SIZE : Standard BASE CABINET: YES

COMMENTS: Upgrade signals + add mast arms