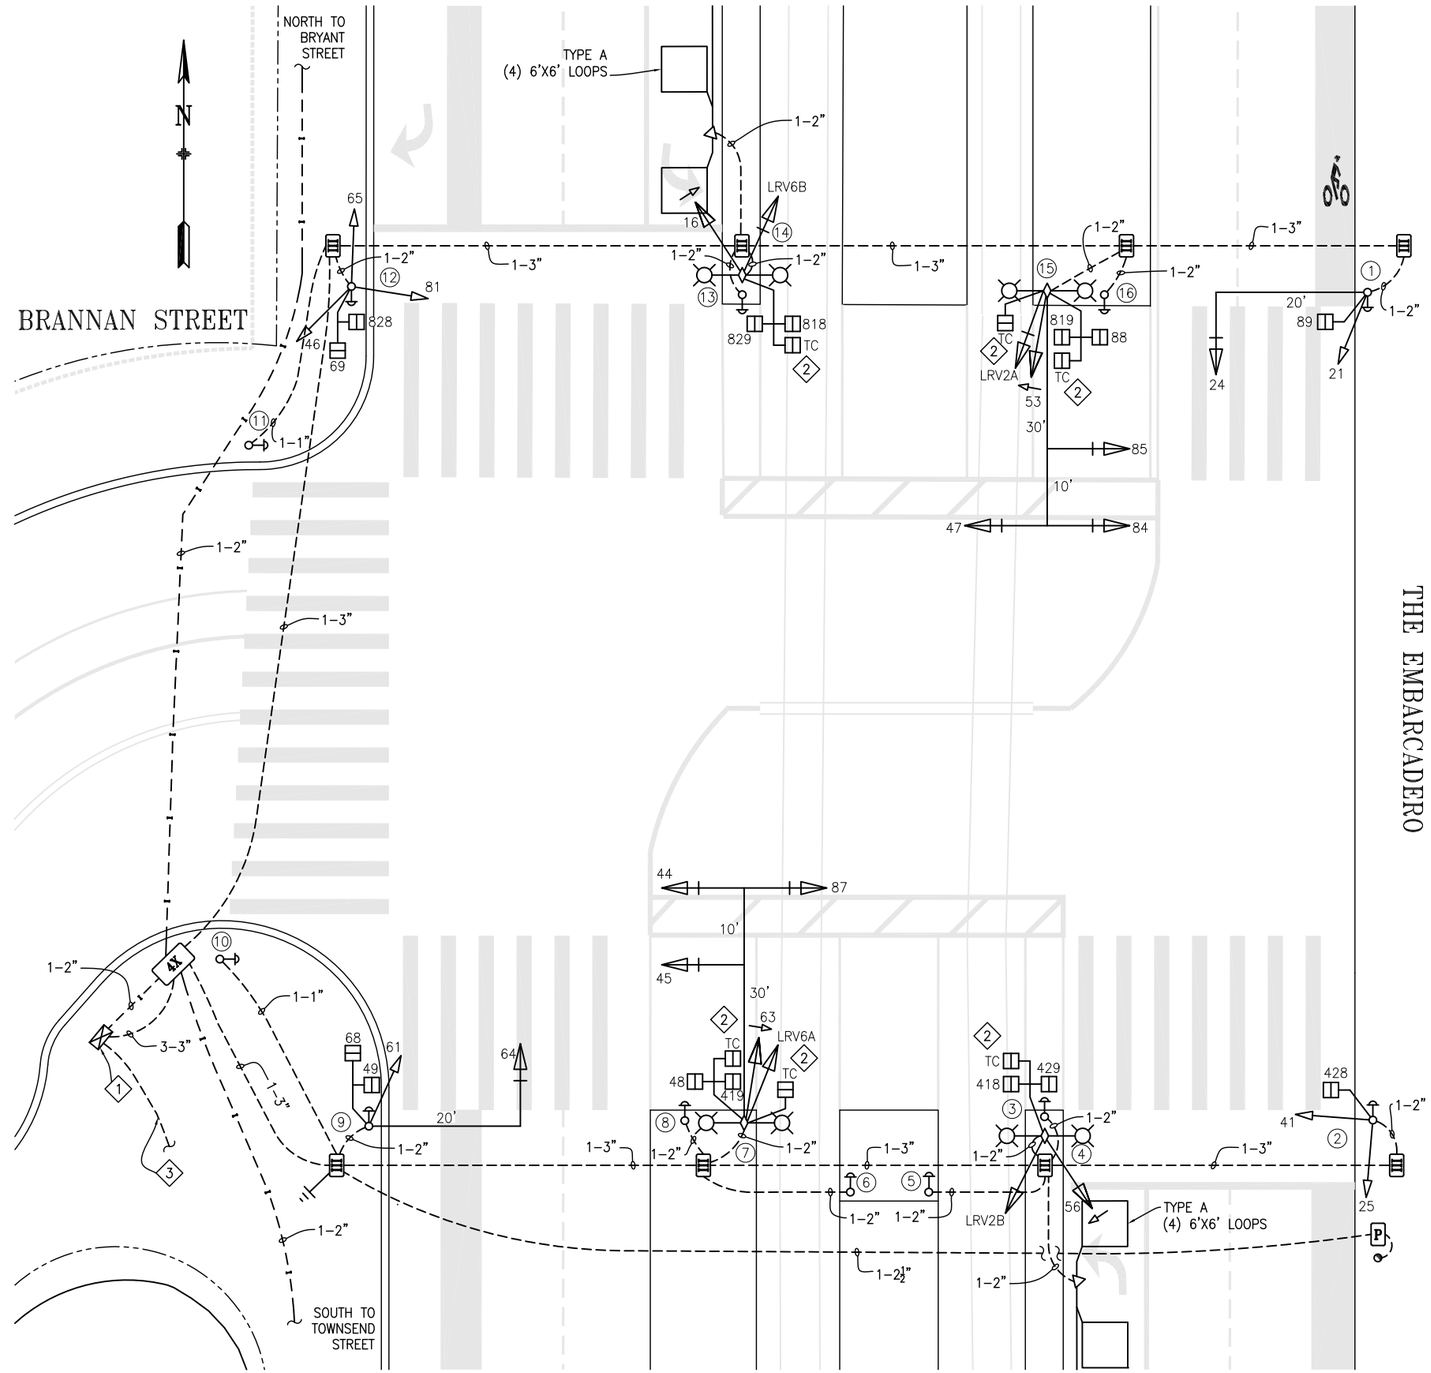

NO.	DATE	DESCRIPTION	BY	APPROVED
1	11/20/21	SRC 2021-038: INSTALLED 24"X24" FTCs ON POLES 7 & 15, CONVERTED FROM MSID/CONTRACTS 6658E & 7152E AS-BUILTS & PER FIELD CHECK	T. YOUNG	M. VELASCO

TABLE OF REVISIONS
CHECKOUT DRAWING THROUGH THE SID CUSTODIAN FOR THE LATEST REVISION

SEAL OF THE CITY AND COUNTY OF SAN FRANCISCO

SFMTA

DRAWN BY: T. YOUNG DATE: 5/2022
CHECKED BY: M. VELASCO DATE: 5/2022

SCALE: 1" = 20'
SHEET OF SHEETS: 1 OF 2

TRAFFIC SIGNAL INVENTORY DIAGRAM

BRANNAN STREET, THE EMBARCADERO, & PIER 34

CNN NO: 23597000
REV NO: 0

POLE AND EQUIPMENT SCHEDULE

POLE No.	TYPE OF POLE	LUMINAIRE TYPE	VEHICLE SIGNAL					PEDESTRIAN SIGNAL			REMARKS
			No.	TYPE	MOUNTING	VISORS	LOUVERS/BP	No.	TYPE	MOUNTING	
1	16-1-70 W/20' MAST ARM		21 24	3S8" 3S12"	SV-1 MAS	T T	BP	89	1S-COUNT	3/–	APS
2	1-A (12')		25 41	3S8" 3S8"	TV-2-T	T T		428	1S-COUNT	3/–	APS
3	PPB POLE (4')										APS
4	COMBINATION POLE (POLE #601)		56 LRV2B	3S12"LA 2S12"LB	SV-1 SV-1	T T		418 429 TC	1S-COUNT 1S-COUNT 1S 16"X16"	1/–	
5	PPB POLE (4')										APS
6	PPB POLE (4')										PPB
7	COMBINATION POLE (POLE #602) W/30' MAST ARM		44 45 87 63 LRV6A TC	3S12" 3S12" 3S12"RYY 3S12"LA 2S12"LB 1S 24X24"	MAS MAS MAS SV-1 SV-1 SV-1	T T T T T T	BP BP BP	48 419 TC	1S-COUNT 1S-COUNT 1S 16"X16"	1/–	
8	PPB POLE (4')										APS
9	16-1-70 W/20' MAST ARM		61 64	3S8" 3S12"	SV-1 MAS	T T	BP	49 68	1S-COUNT 1S-COUNT	2/–	APS
10	PPB POLE (4')										APS
11	PPB POLE (4')										APS
12	1-A (12')		46 65 81	3S8" 3S8" 3S8"RYY	TV-3-T	T FC T	3V	69 828	1S-COUNT 1S-COUNT	2/–	APS
13	PPB POLE (4')										APS
14	COMBINATION POLE (POLE #518)		16 LRV6B	3S12"LA 2S12"LB	SV-1 SV-1	T T	BP	818 829 TC	1S-COUNT 1S-COUNT 1S 16"X16"	1/–	
15	COMBINATION POLE (POLE #517) W/30' MAST ARM		47 84 85 53 LRV2A TC	3S12" 3S12"RYY 3S12"RYY 3S12"LA 2S12"LB 1S 24X24"	MAS MAS MAS SV-1 SV-1 SV-1	T T T T T T	BP BP BP BP	88 819 TC	1S-COUNT 1S-COUNT 1S 16"X16"	1/–	
16	PPB POLE (4')										APS

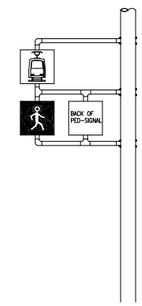

DETAIL 1/–
SCALE : NONE

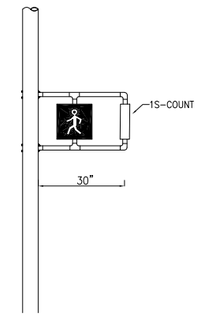

DETAIL 2/–
SCALE : NONE

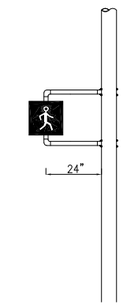

DETAIL 3/–
SCALE : NONE

SHEET NOTES:

1. CABINET FOUNDATION TYPE: M-SF
2. TC = TRAIN COMING
3. TO VTS CABINET – SEE CONTRACT MR-1167R, SHEET E-7 FOR FURTHER DETAILS

NO.	DATE	DESCRIPTION	BY	APPROVED
0	11/20/21	SRC 2021-038: INSTALLED 24"X24" FTCs ON POLES 7 & 15, CONVERTED FROM MSID/CONTRACTS 6658E & 7152E AS-BUILTS & PER FIELD CHECK	T. YOUNG	M. VELASCO

TABLE OF REVISIONS
CHECKOUT DRAWING THROUGH THE SID CUSTODIAN FOR THE LATEST REVISION

SEAL OF THE CITY AND COUNTY OF SAN FRANCISCO

SFMTA

DRAWN BY: T. YOUNG DATE: 5/2022
CHECKED BY: M. VELASCO DATE: 5/2022

SCALE: NO SCALE
SHEET OF SHEETS: 2 OF 2

TRAFFIC SIGNAL INVENTORY DIAGRAM

BRANNAN STREET, THE EMBARCADERO, & PIER 34

CNN NO: 23597000
REV NO: 0