



THE EMBARCADERO

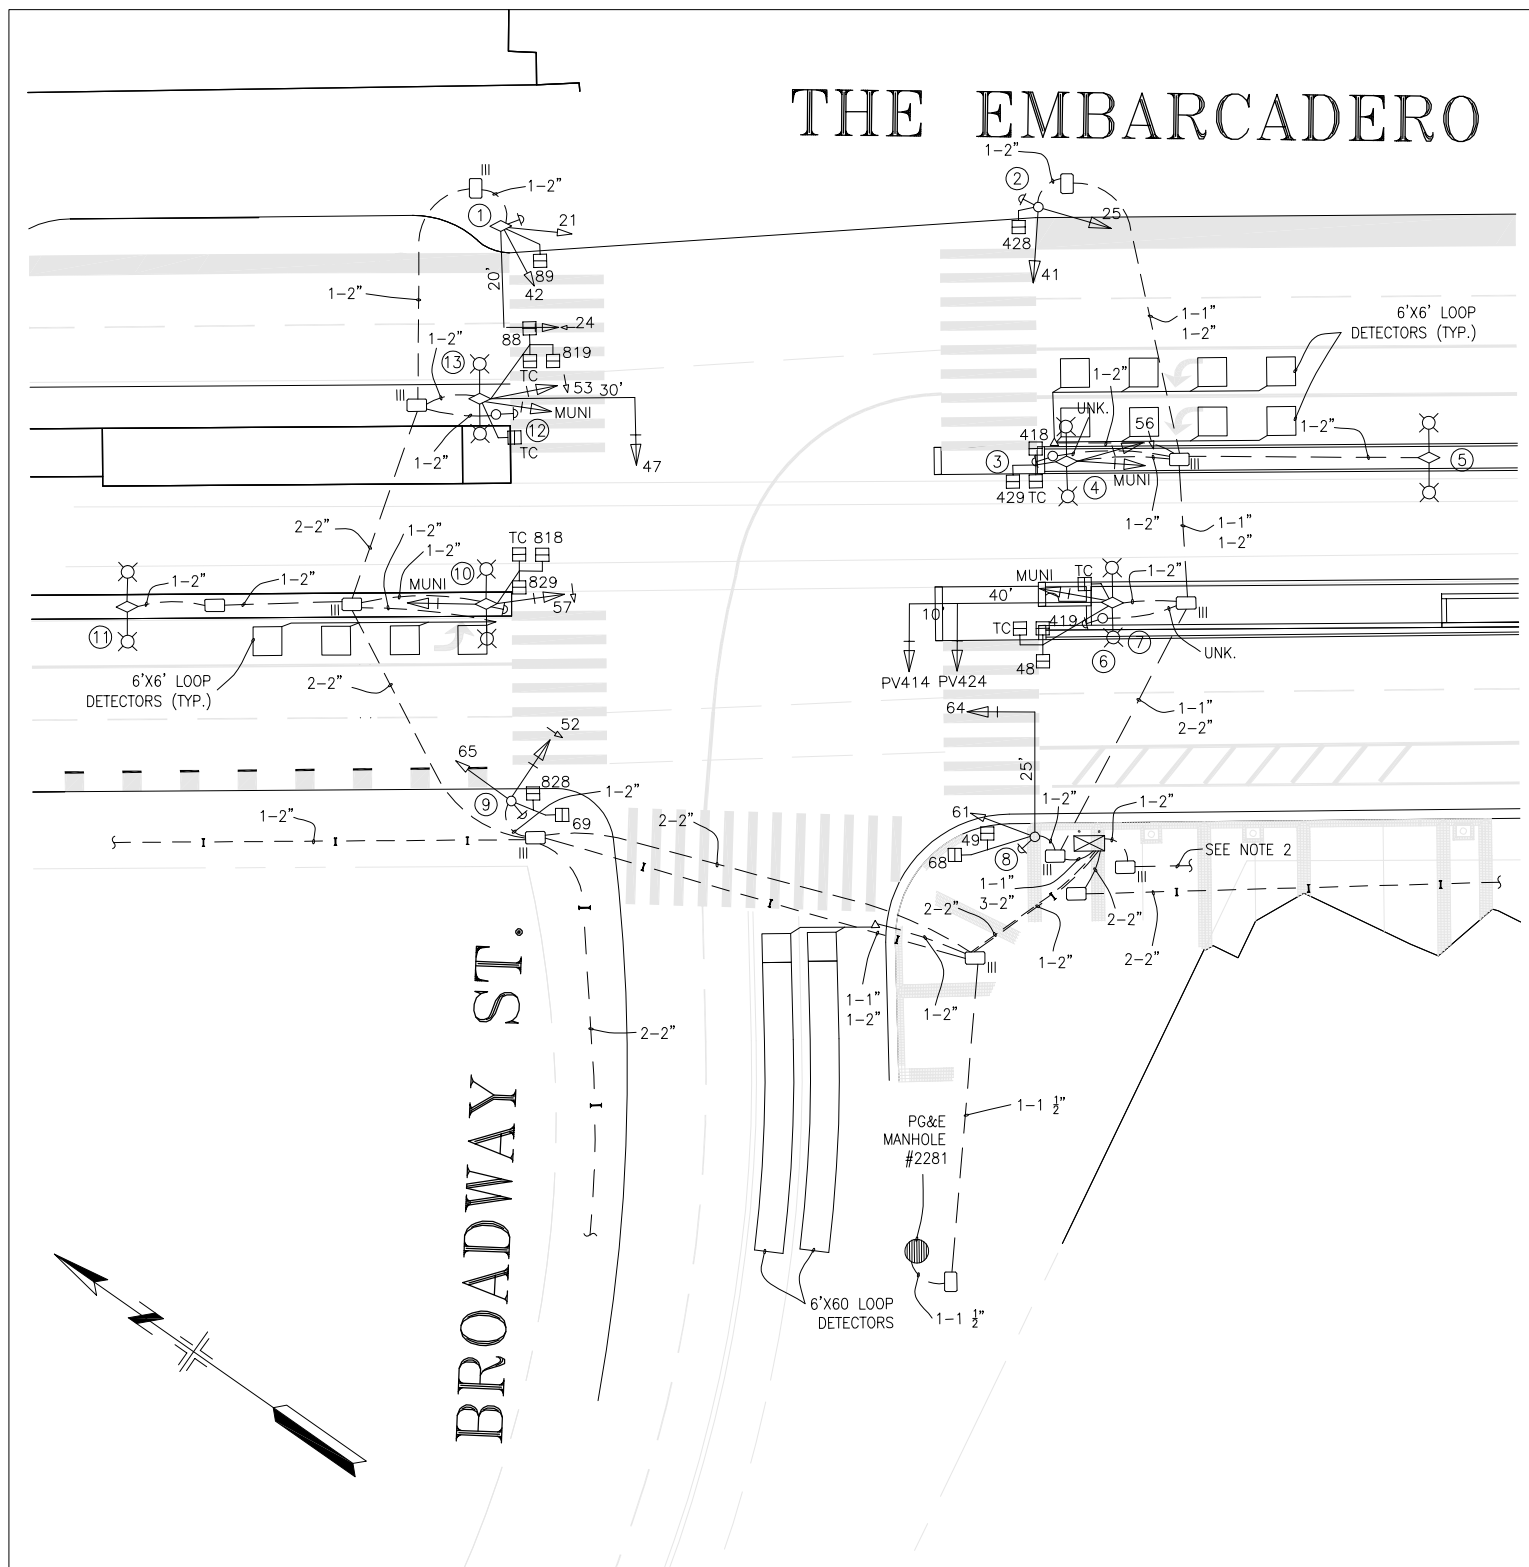

POLE AND EQUIPMENT SCHEDULE

POLE No.	TYPE OF POLE	VEHICLE SIGNAL					PEDESTRIAN SIGNAL			REMARKS
		No.	TYPE	MOUNTING	VISORS	LOUVERS	No.	TYPE	MOUNTING	
①	16-1-70 WITH 20' MAST ARM	21 42 24	3S8" 3S8" 3S12"GVA	SV-2 MAS	T T T		89	1S-COUNT	②	PPB BACKPLATE
②	1-A (10')	25 41	3S12" 3S12"	TV-2-T	T T		428	1S-COUNT	②	PPB
③	PPB POLE									PPB
④	COMBINATION POLE (POLE #250)	56 MUNI	3S12" LA 2S12" LB	SV-1 SV-1	T T		418 429 TC	1S-COUNT 1S-COUNT 1S 16"x16"	③	BACKPLATE BACKPLATE
⑤	COMBINATION POLE (POLE #252)									NOT USED
⑥	PPB POLE									PPB
⑦	COMBINATION POLE (POLE #251) WITH 40' MAST ARM	MUNI 414 424	2S12" LB 3S12" 3S12"	SV-1 MAS MAS	T T T		48 419 TC TC	1S-COUNT 1S-COUNT 1S 16"x16" 1S 24"x24"	③ SP-1	BACKPLATE BACKPLATE BACKPLATE
⑧	18-1-70 WITH 25' MAST ARM	61 64	3S8" 3S12"	SV-1 MAS	T T		49 68	1S-COUNT 1S-COUNT	①	BACKPLATE, PPB
⑨	1-A (10')	52 65	3S12" LA 3S8"	TV-2-T	T T		69 828	1S-COUNT 1S-COUNT	①	BACKPLATE, PPB
⑩	COMBINATION POLE (POLE #7)	57 MUNI	3S12" LA 2S12" LB	SV-1 SV-1	T T		818 829 TC	1S-COUNT 1S-COUNT 1S 16"x16"	③	BACKPLATE BACKPLATE, PPB BACKPLATE
⑪	COMBINATION POLE (POLE #9)									NOT USED
⑫	PPB POLE									PPB
⑬	COMBINATION POLE (POLE #8) WITH 30' MAST ARM	47 53 MUNI	3S12" 3S12" LA 2S12" LB	MAS SV-1 SV-1	T T T		88 819 TC TC	1S-COUNT 1S-COUNT 1S 16"x16" 1S 24"x24"	③ SP-1	BACKPLATE BACKPLATE BACKPLATE

NOTES:
 1. CABINET FOUNDATION TYPE: M
 2. TO VETAG CABINET - SEE SPECIFICATION NO. 6094Q, SHEET TE-10 FOR FURTHER DETAILS
 3. TC = TRAIN COMING

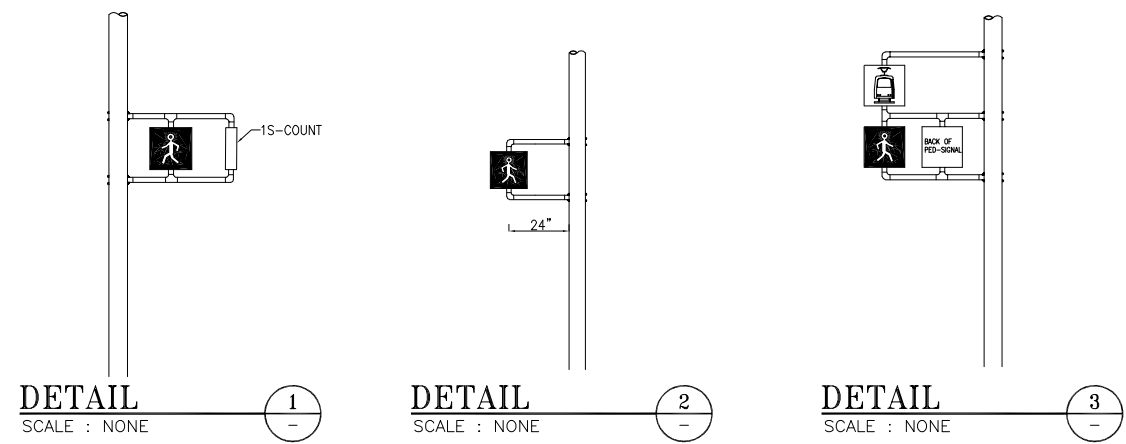

NO.	DATE	DESCRIPTION	BY	APPROVED
2	3/1/22	SRC 2021-300: DELETE SIGNALS 16, 13. ADD GVA TO SIGNAL 24	J. Suhaimi	G. Ho
1	2/17/20	UPDATES PER FIELD.	C. Leung	C. Liu
0	7/XX/19	SRC 2019-255: UPGRADED 24"x24" TC ON POLES 7 & 13	T. Young	M. Velasco
0		CONVERTED FROM MSID.		

TABLE OF REVISIONS
 CHECKOUT DRAWING THROUGH THE SID CUSTODIAN FOR THE LATEST REVISION



DRAWN BY:	DATE:
T. Young	07/2019
CHECKED BY:	DATE:
M. Velasco	07/2019

SCALE:
 1" = 20'
 SHEET OF SHEETS
 1 OF 1

TRAFFIC SIGNAL INVENTORY DIAGRAM
 BROADWAY & THE EMBARCADERO

CNN NO:
 24570000
 REV NO:
 2