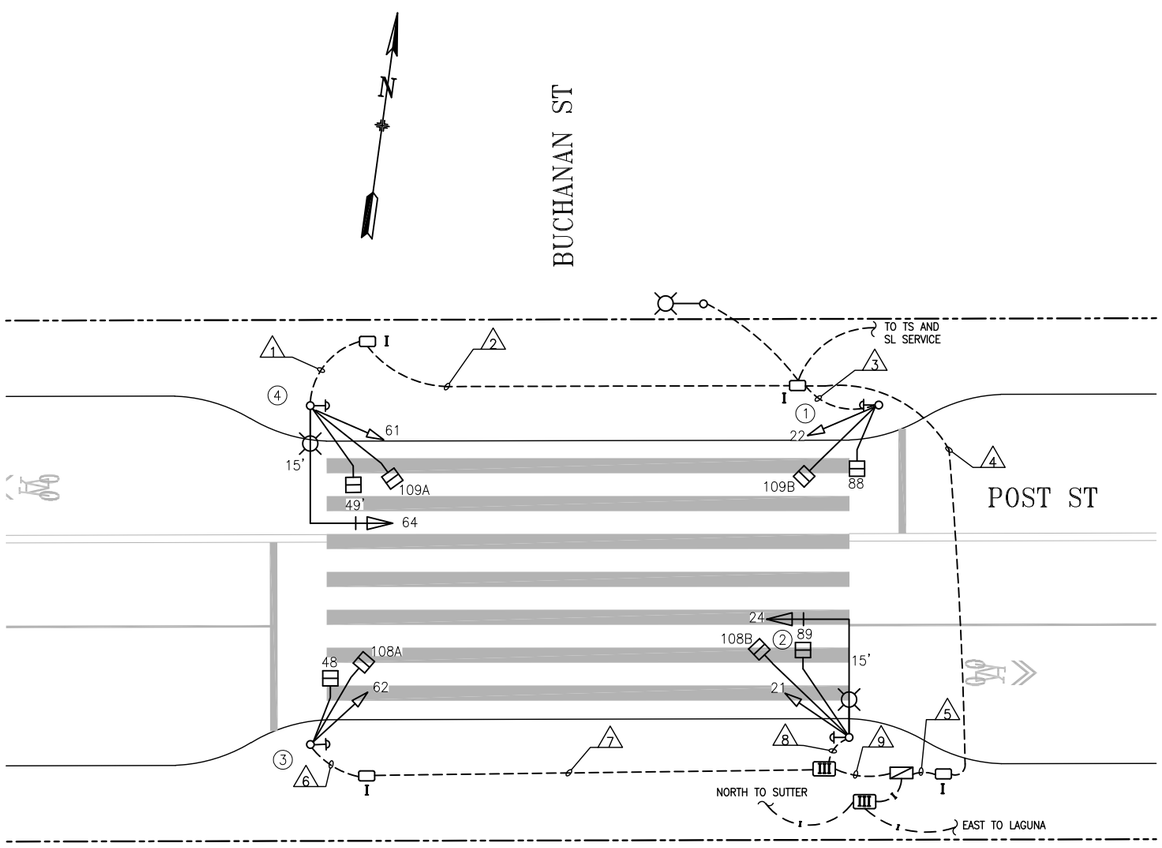

10 0 10 20
SCALE IN FEET

POLE AND EQUIPMENT SCHEDULE

POLE No.	TYPE OF POLE	LUMINAIRE TYPE	VEHICLE SIGNAL					PEDESTRIAN SIGNAL			REMARKS
			No.	TYPE	MOUNTING	VISORS	LOUVERS/BP	No.	TYPE	MOUNTING	
1	1-B (10')		22	3S8"	TV-1	T		88 109B	1S-COUNT 1S-COUNT	SP-2-T (1/–)	APS-3W
2	17B-1-70 w/15' MAST ARM 6' LUMINAIRE ARM		21 24	3S8" 3S12"	SV-1-T MAS	T T	BP	89 108B	1S-COUNT 1S-COUNT	SP-2-T (1/–)	APS-3W
3	1-B (10')		62	3S8"	TV-1	T		48 108A	1S-COUNT 1S-COUNT	SP-2-T (1/–)	APS-3W
4	17B-1-70 w/15' MAST ARM 6' LUMINAIRE ARM		61 64	3S8" 3S12"	SV-1-1 MAS	T T	BP	49 109A	1S-COUNT 1S-COUNT	SP-2-T (1/–)	APS-3W

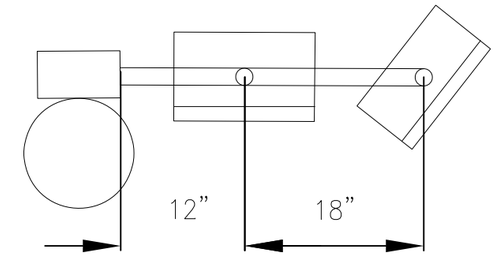

SP-2-T DETAIL (1/–)
(N.T.S.)

NO.	DATE	DESCRIPTION	BY	APPROVED
1	03/06/22	INSTALL APS (SRC 2021-058) AND CONVERT FROM 0435J CONTRACT 28-29 CONTRACT PLANS	E.LUU	G. DELEON

TABLE OF REVISIONS
CHECKOUT DRAWING THROUGH THE SID CUSTODIAN FOR THE LATEST REVISION

SEAL OF THE CITY AND COUNTY OF SAN FRANCISCO

SFMTA

DRAWN BY: E. LUU DATE: 02/2023
CHECKED BY: G. DE LEON DATE: 02/2023

SCALE: AS SHOWN
SHEET OF SHEETS: 01 OF 02

TRAFFIC SIGNAL INVENTORY DIAGRAM

BUCHANAN STREET & POST STREET

CNN NO: 26522000
REV NO: 0

CONDUIT AND WIRING SCHEDULE

CONDUIT RUN NUMBER		1	2	3	4	5	6	7	8	9
CONDUIT SIZE (INCH)		2	2	UNK	2	2	UNK	2	2	UNK
NOTES										
	VEH. SIGNAL 61	3	3		3	3				
	VEH. SIGNAL 64	3	3		3	3				
	PED. SIGNAL 49	2	2		2	2				
	PED. SIGNAL 109A	2	2		2	2				
	VEH. SIGNAL 22			3	3	3				
	PED. SIGNAL 88			2	2	2				
	PED. SIGNAL 109B			2	2	2				
	VEH. SIGNAL 62						3	3		3
	PED. SIGNAL 48						2	2		2
	PED. SIGNAL 108A						2	2		2
	VEH. SIGNAL 21								3	3
	VEH. SIGNAL 24								3	3
	PED. SIGNAL 89								2	2
	PED. SIGNAL 108B								2	2
	#14 NEUTRAL	3		2			2		3	
	#14 SPARE		3		3	3		3		3
	TOTAL #14 WIRES	13	13	9	20	20	9	10	13	20
	#10 WIRES NEUTRAL		1		1	1		1		1
	#10 WIRES STREETLIGHT	2							2	
	#8 WIRES STREETLIGHT		2		2					
	#8 WIRES (120 V TS SERVICE)				2	2				
	#8 BSCW				1	1				

NO.	DATE	DESCRIPTION	BY	APPROVED
0	3/6/22	CONVERT FROM 0435J CONTRACT 28-29 CONTRACT PLANS	E. LUU	G. DELEON

TABLE OF REVISIONS
CHECKOUT DRAWING THROUGH THE SID CUSTODIAN FOR THE LATEST REVISION

SEAL OF THE CITY AND COUNTY OF SAN FRANCISCO

SFMTA

DRAWN BY: E. LUU DATE: 02/2023
CHECKED BY: G. DE LEON DATE: 02/2023

SCALE: AS SHOWN
SHEET OF SHEETS: 02 OF 02

TRAFFIC SIGNAL INVENTORY DIAGRAM
BUCHANAN STREET & POST STREET

CNN NO: 26522000
REV NO: 0