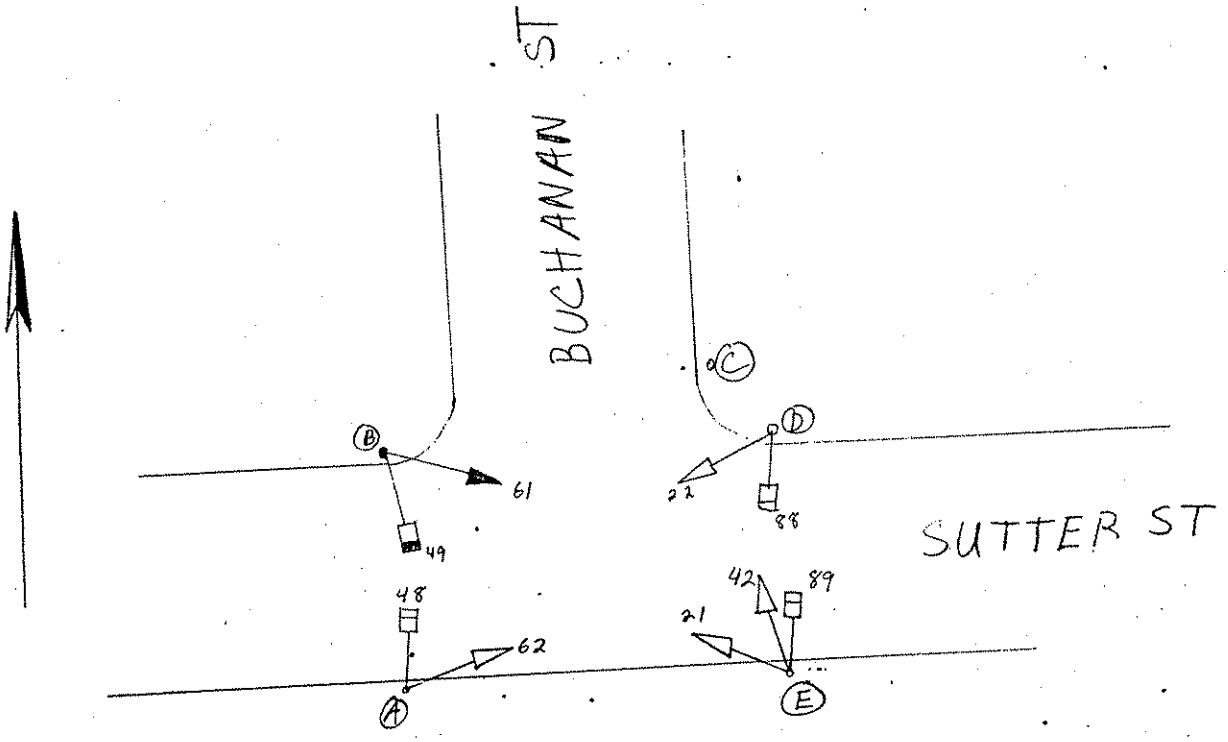

Buchanan St & Sutter St

4/3/02
8/24/05

POLE	FUNC.	MAT'L	SIGNAL NO.	MAKE	NO. OF SECT.	SIZE	VISOR	B.P. OR LOUVERS	MOUN'T
A	M	S	62	~~GA~~ EC	3	8"	FC	—	SV-1
B	M/L	S	61	EC	3	8"	T	-	SV-1
C	L	S	22	~~GA~~ EC	3	8"	F C	—	TV-1
D	S	S	42	~~GA~~ EC	3	8"	FC	—	SV-2
E	L	S	21	~~GA~~ EC	3	8"	FC	—	SV-2

PED SIGNAL NO.	LEGEND	MESSAGE ELEMENT	MESSAGE COLOR	MAKE	MOU
48	I	IS-I	W/OR	ICC	SP
49	"	"	"	"	"
88	"	"	"	"	"
89	"	"	"	"	"

CONTROLLER CABINET SIZE : Ordinary BASE CABINET : no

COMMENTS :