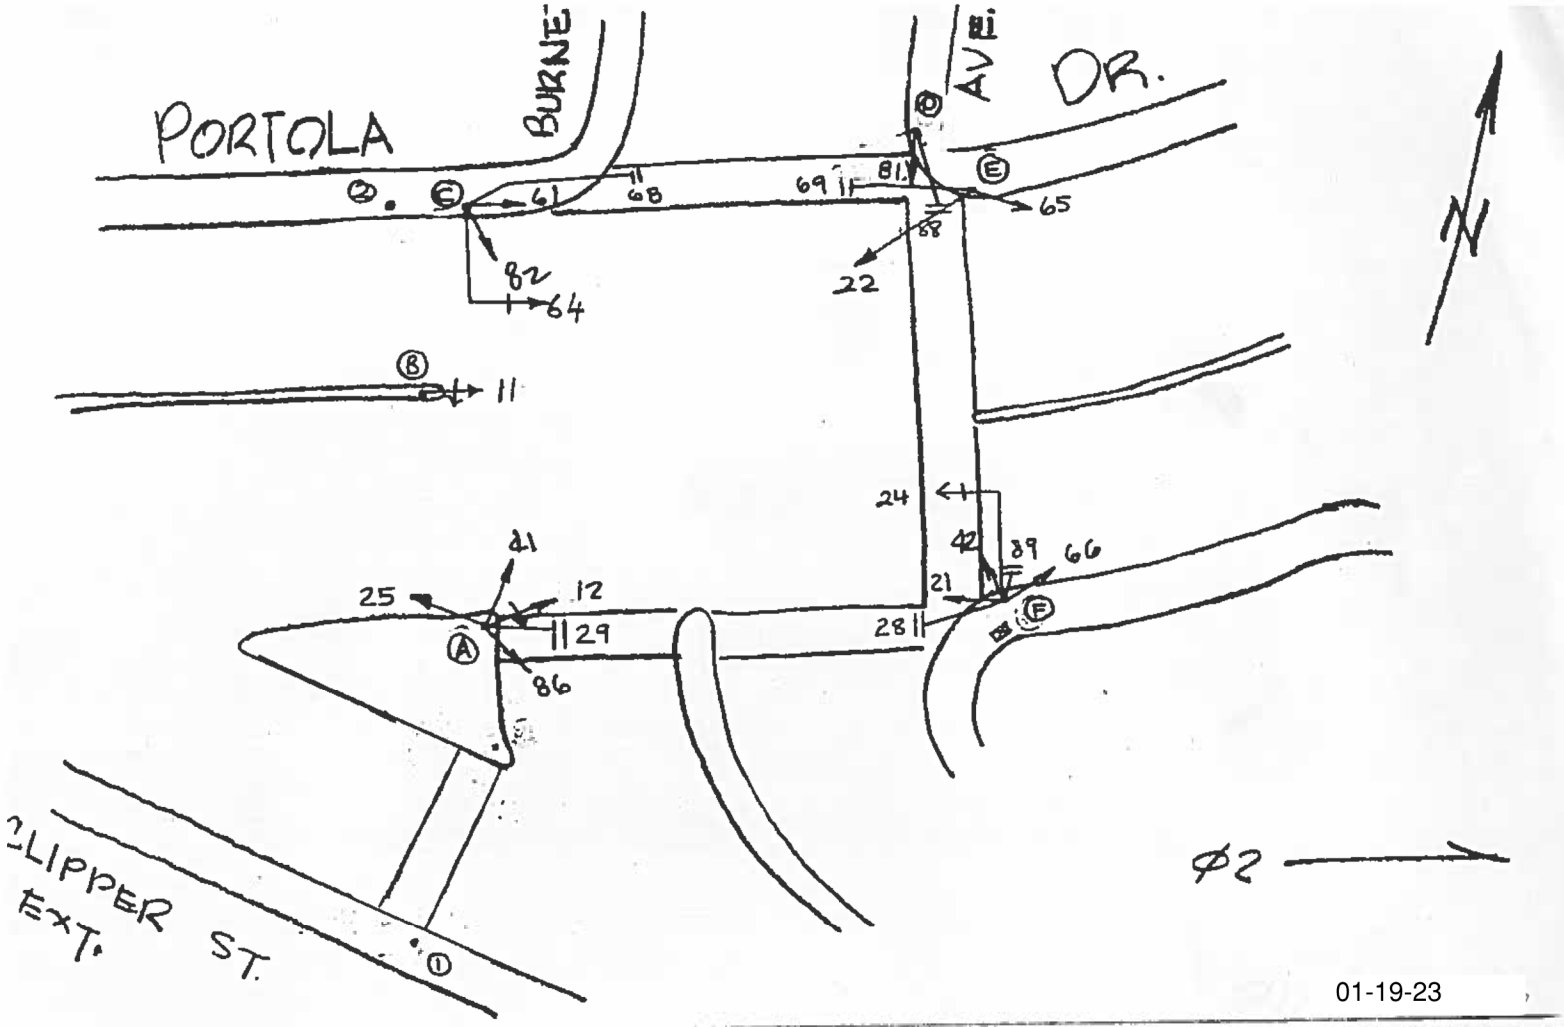

*4S12" (Red Arrow, Yellow Arrow, Flashing Yellow Left Arrow, Green Left Arrow)

POLE	FUNC.	MAT'L
A	S	C
B	S	S
C	S	S
D	S	C
E	S	S
F	S	S
1	L	C
2	L	C

SIGNAL NO.	MAKE	NO. OF SECT.	SIZE	VISOR	B.P. OR LOUVERS	MOUN'T
65	ICC	3	12"	T 12"	NO	T
25	TCT	3	12"	T 12"	NO	S
41	EC	3	12"	T 12"	NO	S
12	TCT	4*	12"	T 12"	NO	S
86	EC	3	12"	T 12"	NO	S
82	TCT	4	RYGG 12"	T 12"	NO	S
61	TCT	3	12"	T 12"	NO	S
22	ICC	3	8"	FC 8"	NO	T
81	ICC	3	12"	T 12"	NO	S
66	ICC	3	12"	T 12"	NO	S
42	ICC	3	8" G, Y, R 12" G←	T 8" T 12"	NO	S
21	ICC	3	8"	FC 8"	NO	S
11	TCT	4*	12"	FC 12"	NO	T
64	TCT	3	12"	FC 12"	BP	A
24	ICC	3	12"	T 12"	BP	A

PED SIGNAL NO.	LEGEND	MESSAGE ELEMENT	MESSAGE COLOR	MAKE	MOUN'
28	I	IS-I	WH/OR	ICC	S
29	I	IS-I	WH/OR	ICC	S
88	I	IS-I	WH/OR	ICC	S
89	I	IS-I	WH/OR	ICC	S
68	I	IS-I	WH/OR	ICC	S
69	I	IS-I	WH/OR	ICC	S

CONTROLLER CABINET SIZE : LARGE BASE CABINET: NO

COMMENTS :

Per Shop Maintenance: Upgraded Signals 25, 41, and 86 to 3S12" after damage.
C.Skerrit, 01/19/2023