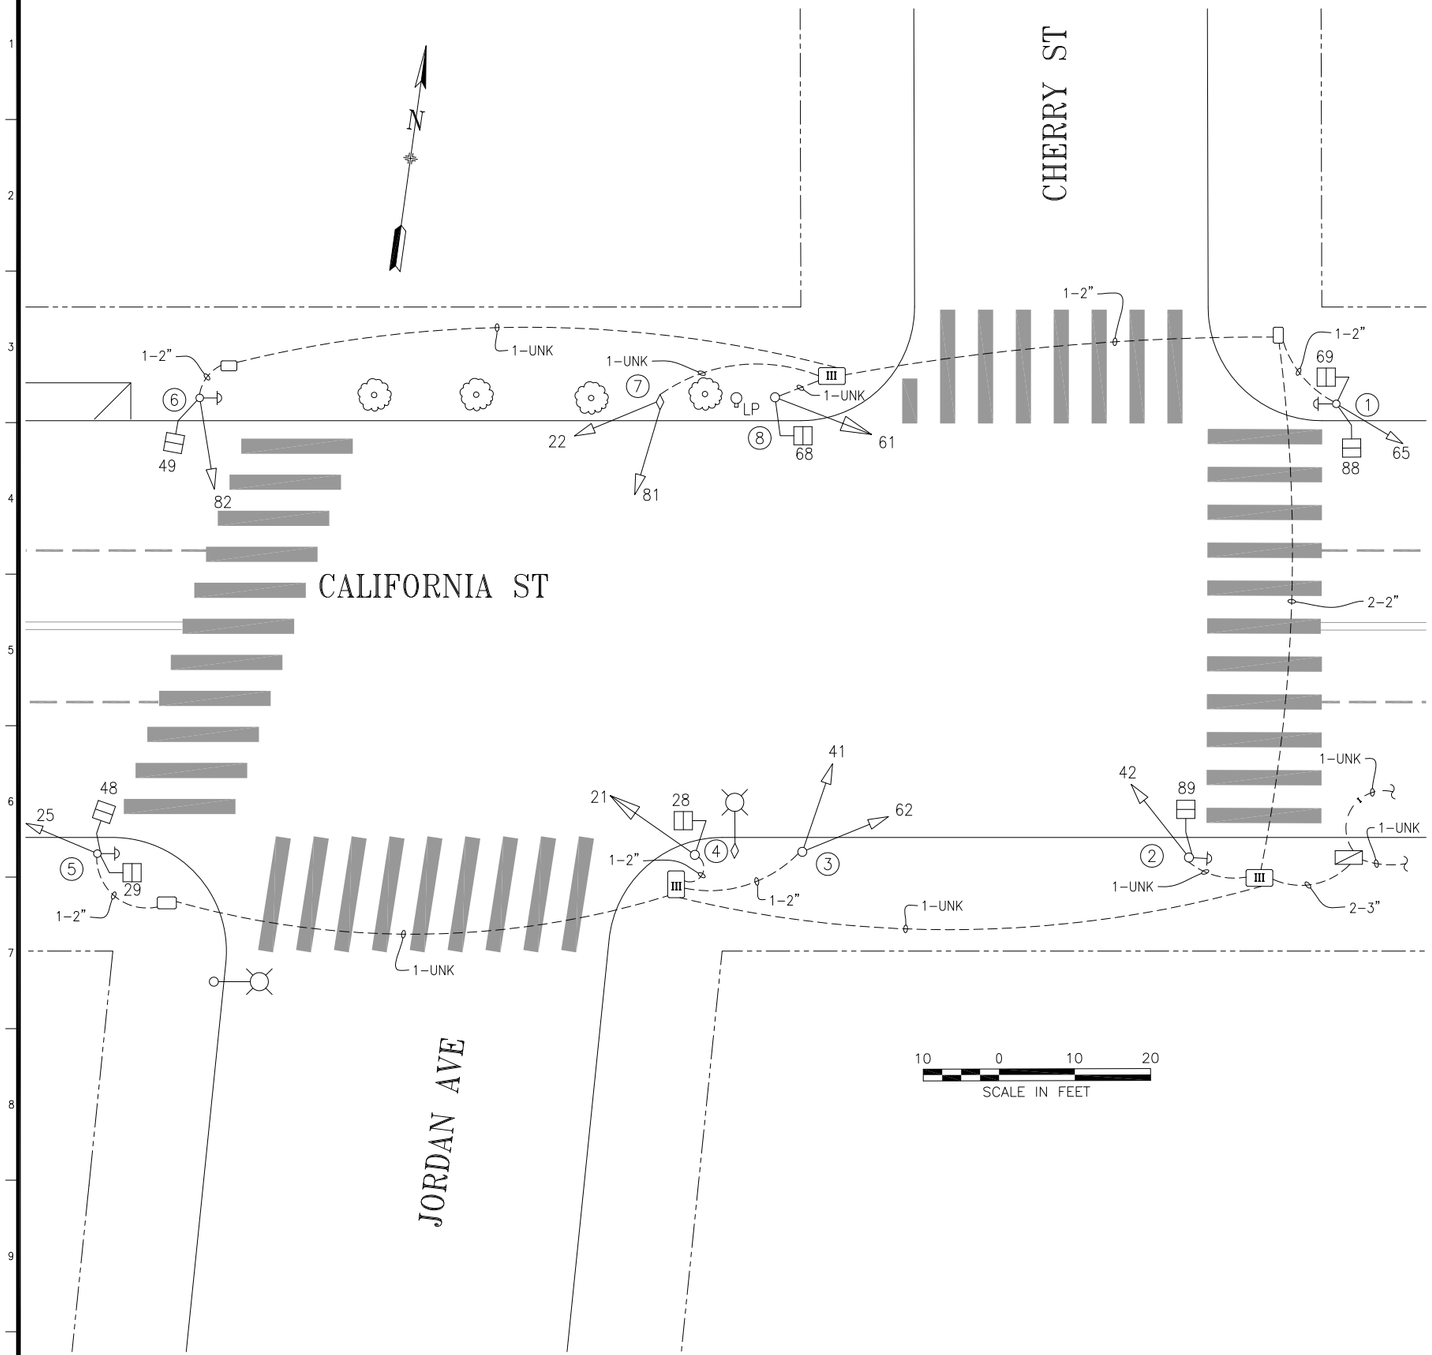

POLE AND EQUIPMENT SCHEDULE

POLE No.	TYPE OF POLE	LUMINAIRE VOLTAGE/ WATTAGE	VEHICLE SIGNAL					PEDESTRIAN SIGNAL			REMARKS
			No.	TYPE	MOUNTING	VISORS	LOUVERS	No.	TYPE	MOUNTING	
1	1-A (10')		65	3S8"	TV-1-T	T		69 88	1S-COUNT 1S-COUNT	SP-1 SP-1	PPB
2	10' MARBELITE POLE		42	3S8"	TV-1-T	T		89	1S-COUNT	SP-1	PPB
3	1-A (10')		41 62	3S8" 3S8"	TV-2-T	T T					
4	1-A (10')		21	3S12"	TV-1-T	T		28	1S-COUNT	SP-1	
5	1-A (10')		25	3S8"	TV-1-T	T		29 48	1S-COUNT 1S-COUNT	SP-1 SP-1	PPB
6	1-A (10')		82	3S8"	TV-1-T	T		49	1S-COUNT	SP-1	PPB
7	MUNI POLE		22 81	3S8" 3S8"	SV-2-TC	T T					EXTERNAL CONDUIT
8	10' MARBELITE POLE		61	3S12"	TV-1-T	T		68	1S-COUNT	SP-1	

NO.	DATE	DESCRIPTION	BY	APP.
0	11/03/04	UPGRADE ACTIVATED THRU 0435J-CONVERTED FROM AS BUILTS	ASCALES	GDeLEON

TABLE OF REVISIONS
CHECK WITH TRACING TO SEE IF YOU HAVE LATEST REVISION

REFERENCE INFORMATION & FILE NO. OF SURVEYS

SAN FRANCISCO MUNICIPAL TRANSPORTATION AGENCY
CITY AND COUNTY OF SAN FRANCISCO

DRAWN: AScales DATE: 8/18/17
CHECKED: GDeLeon DATE: 8/18/17

SCALE: AS SHOWN
SHEET OF SHEETS: 1 OF 1

TRAFFIC SIGNAL INVENTORY DIAGRAM
CALIFORNIA STREET, CHERRY STREET, AND JORDAN AVENUE

CNN NO. 27569000
REV NO. 0