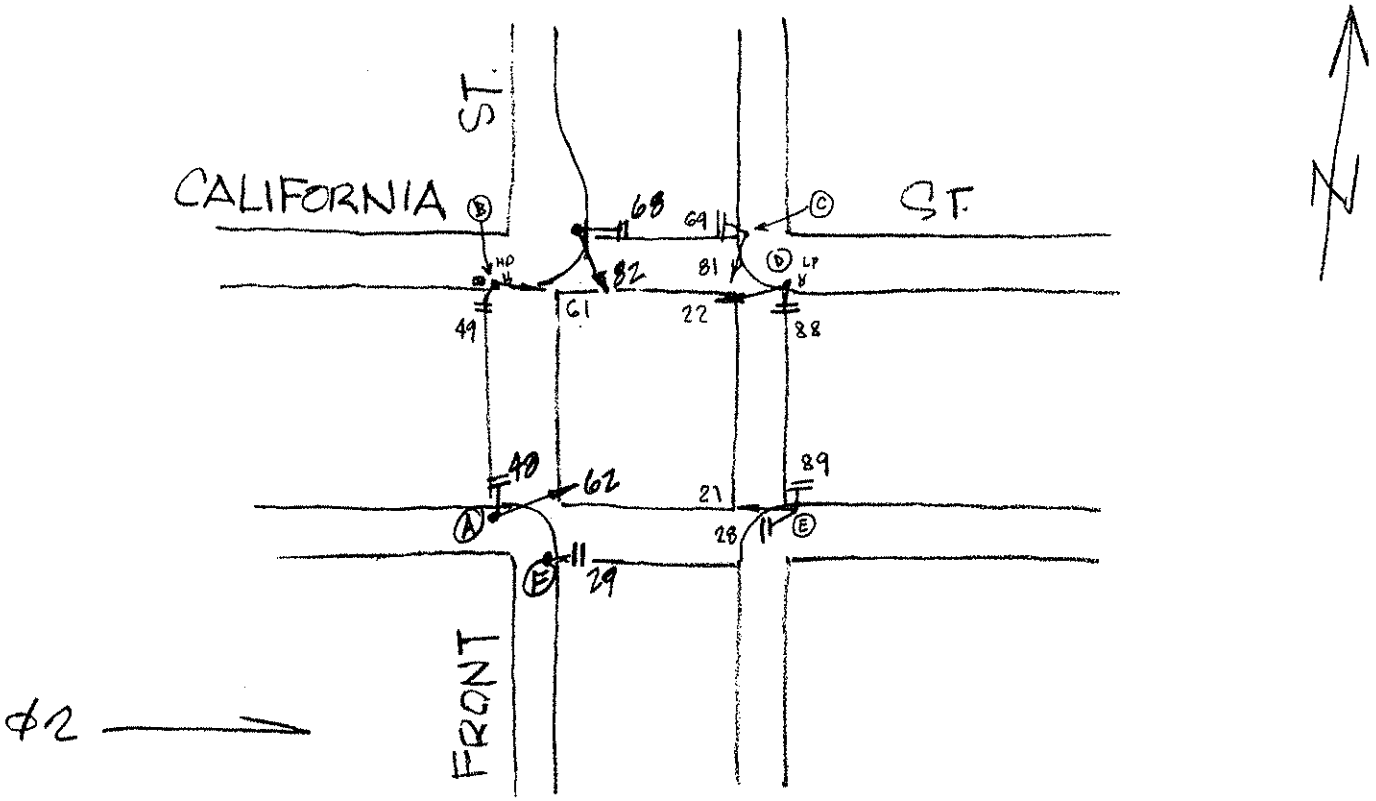

AS OF 2-7-94

POLE	FUNC.	MAT'L
A	S	S
B	L	S
C	L	S
D	S	S
E	L	S
F	L	S

SIGNAL NO.	MAKE	NO. OF SECT.	SIZE	VISOR	B.P. OR LOUVERS	MOUN'T
62	EC	3	8"	FC8	NO	T
82	EC	3	8"	FC 8"	NO	T
61	EC	3	8"	FC 8"	NO	S
81	EC	3	8"	FC 8"	NO	S
22	EC	3	8"	FC 8"	NO	T
21	EC	3	8"	FC 8"	NO	S

PED SIGNAL NO.	LEGEND	MESSAGE ELEMENT	MESSAGE COLOR	MAKE	MOUN'T
29	I	1S-I	W/OR	ICC	S
48	I	1S-I	W/OR	ICC	S
49	I	1S-I	W/OR	ICC	S
68	I	1S-I	W/OR	ICC	S
69	I	1S-I	W/OR	ICC	S
88	I	1S-I	W/OR	ICC	S
89	I	1S-I	W/OR	ICC	S
28	I	1S-I	W/OR	ICC	S

CONTROLLER CABINET SIZE : ORDINARY BASE CABINET: YES

COMMENTS: UPGRADED ALL PED SIGNALS TO ICC.