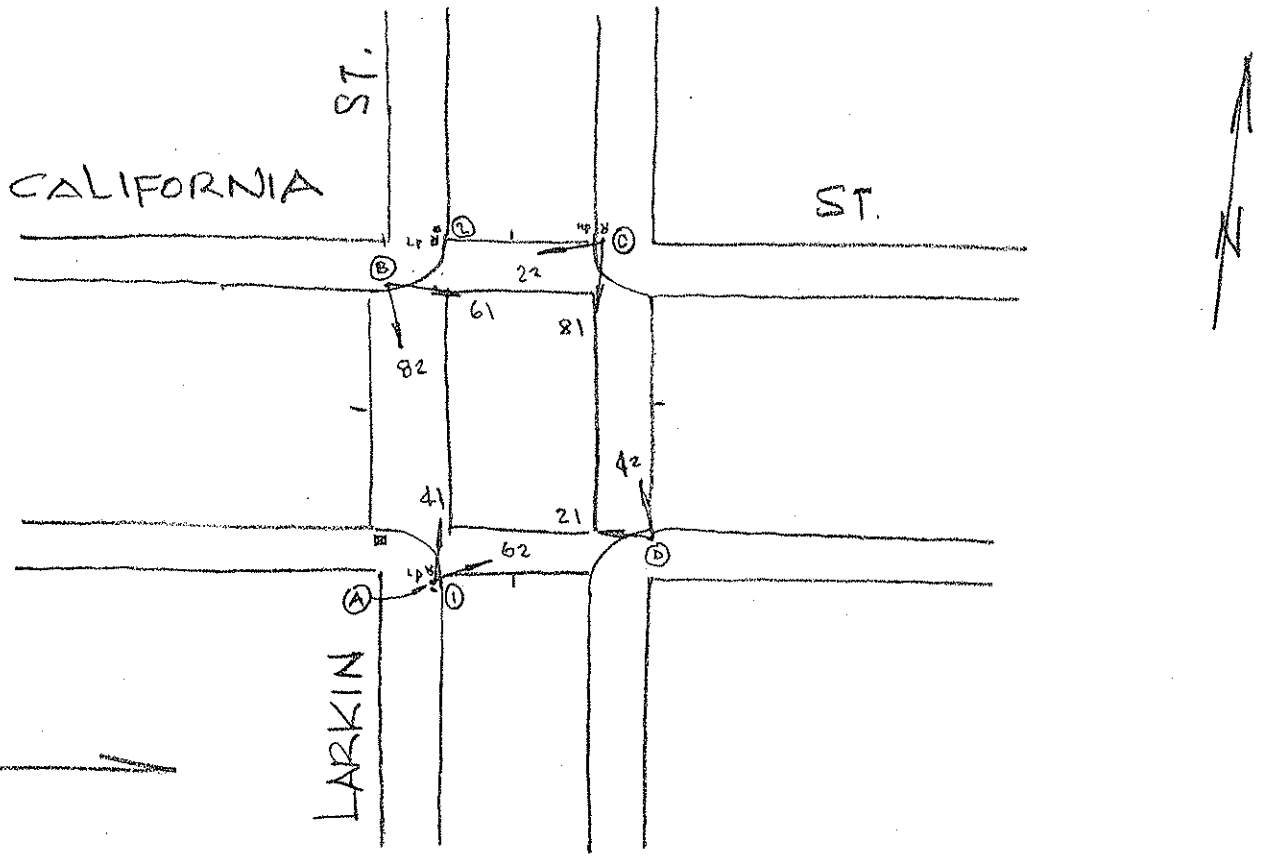

#2

8-6-79

POLE	FUNC.	MAT'L
A	L	S
B	L	S
C	L	S
D	L	S
1	U	W
2	U	W

SIGNAL NO.	MAKE	NO. OF SECT.	SIZE	VISOR	B.P. OR LOUVERS	MOUN'T
62	GA	3	8"	FC 8"	NO	S
41	GA	3	8" R,Y,Y	FC 8"	NO	S
82	EC	3	8"	FC 8"	NO	S
61	EC	3	8"	FC 8"	NO	S
22	GA	3	8"	FC 12"	NO	S
81	GA	3	8"	FC 12"	NO	S
42	GA	3	8" R,Y,Y	FC 8"	NO	S
21	GA	3	8"	FC 8"	NO	S

PED SIGNAL NO.	LEGEND	MESSAGE ELEMENT	MESSAGE COLOR	MAKE	MOUN'T

CONTROLLER CABINET SIZE : ORDINARY BASE CABINET: NO

COMMENTS :