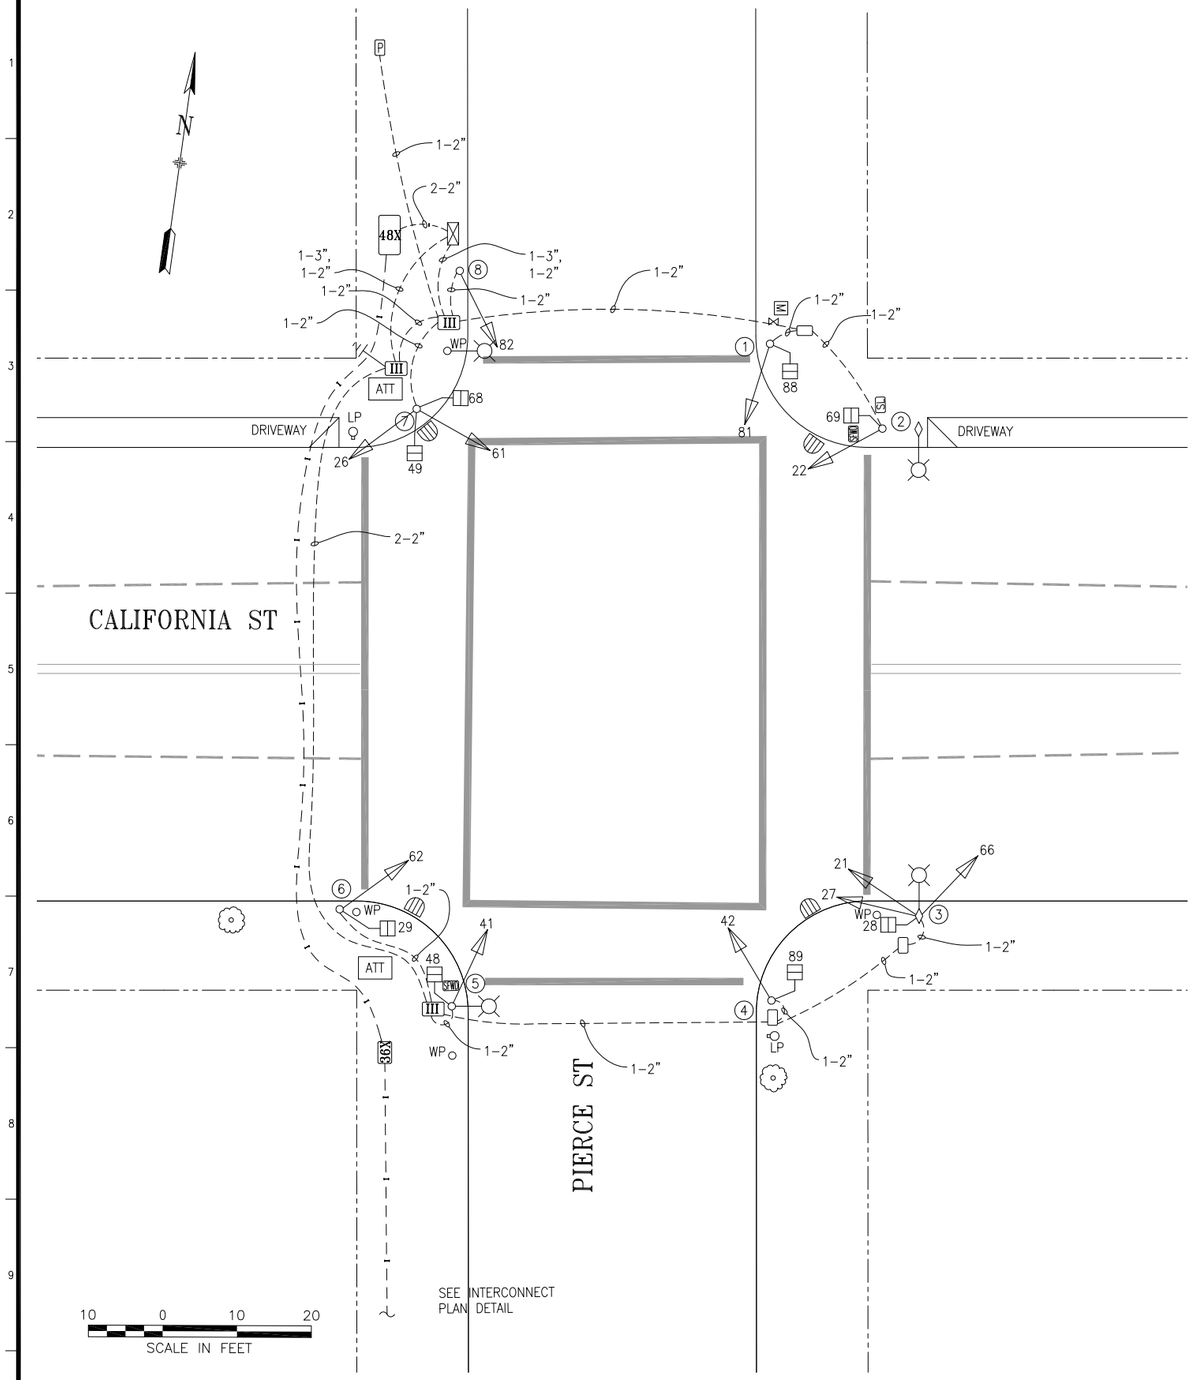

POLE AND EQUIPMENT SCHEDULE

POLE No.	TYPE OF POLE	LUMINAIRE VOLTAGE/ WATTAGE	VEHICLE SIGNAL					PEDESTRIAN SIGNAL			REMARKS
			No.	TYPE	MOUNTING	VISORS	LOUVERS	No.	TYPE	MOUNTING	
1	1-A (10')		81	3S12"	TV-1-T	T		88	1S-COUNT	SP-1	
2	1-A (10')		22	3S12"	TV-1-T	T		69	1S-COUNT	SP-1	
3	EX MUNI		21 21 21	3S12" 3S12" 3S12"	SV-1 SV-1-T SV-1-T	T T T		28	1S-COUNT	SP-1	21 & 66 MOUNTED AT 10' 27 MOUNTED AT 17'
4	1-A (10')		42	3S12"	TV-1-T	T		89	1S-COUNT	SP-1	
5	EX SL		41	3S12"	SV-1-T	T		48	1S-COUNT	SP-1	
6	1-A (10')		62	3S12"	TV-1-T	T		29	1S-COUNT	SP-1 (22')	
7	1-A (10')		61 26	3S12" 3S12"	TV-2-T	T T		49 68	1S-COUNT 1S-COUNT	SP-1-SF (12') SP-1 (22')	
8	1-A (10')		82	3S12"	TV-1-T	T					

PHASE DIAGRAM

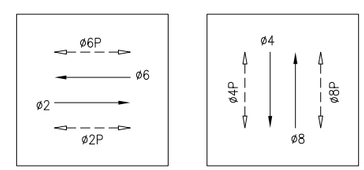

PHASE SEQUENCE
(STEADY DEMAND)

G	Y	R				CALIFORNIA ST (EB & WB) – ø2 & ø6
R		G	Y	R		PIERCE ST (SB & NB) – ø4 & ø8
WM	FRH	RH				PED XING PIERCE ST (SS & NS) – ø2P & ø6P
RH		WM	FRH	RH		PED XING CALIFORNIA ST (WS & ES) – ø4P & ø8P

INTERCONNECT PLAN
NOT TO SCALE

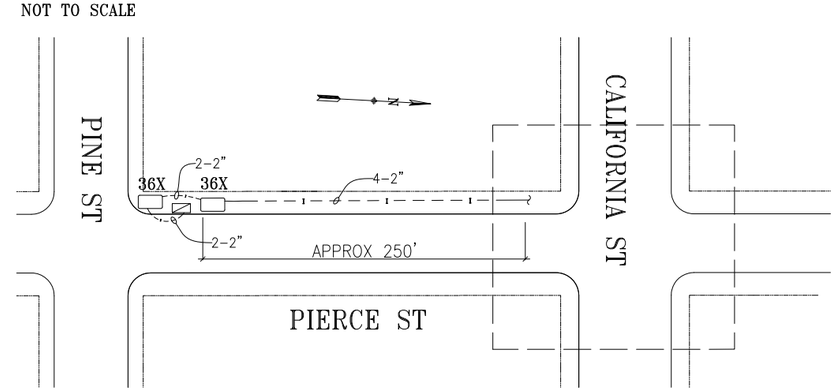

NO.	DATE	DESCRIPTION	BY	APP.
0	05/24/12	NEW SIGNAL ACTIVATED THROUGH CT 60	GH	GD

TABLE OF REVISIONS
CHECK WITH TRACING TO SEE IF YOU HAVE LATEST REVISION

REFERENCE INFORMATION & FILE NO. OF SURVEYS

SAN FRANCISCO MUNICIPAL TRANSPORTATION AGENCY
CITY AND COUNTY OF SAN FRANCISCO

DESIGNED: GD	DATE: 12/2013	
DRAWN: GD	DATE: 12/2013	
CHECKED: MV	DATE: 12/2013	

SCALE: AS SHOWN

SHEET OF SHEETS 1 OF 1

TRAFFIC SIGNAL INVENTORY DIAGRAM

CALIFORNIA ST AND PIERCE ST

CNN NO. 26640000

REV NO. 0