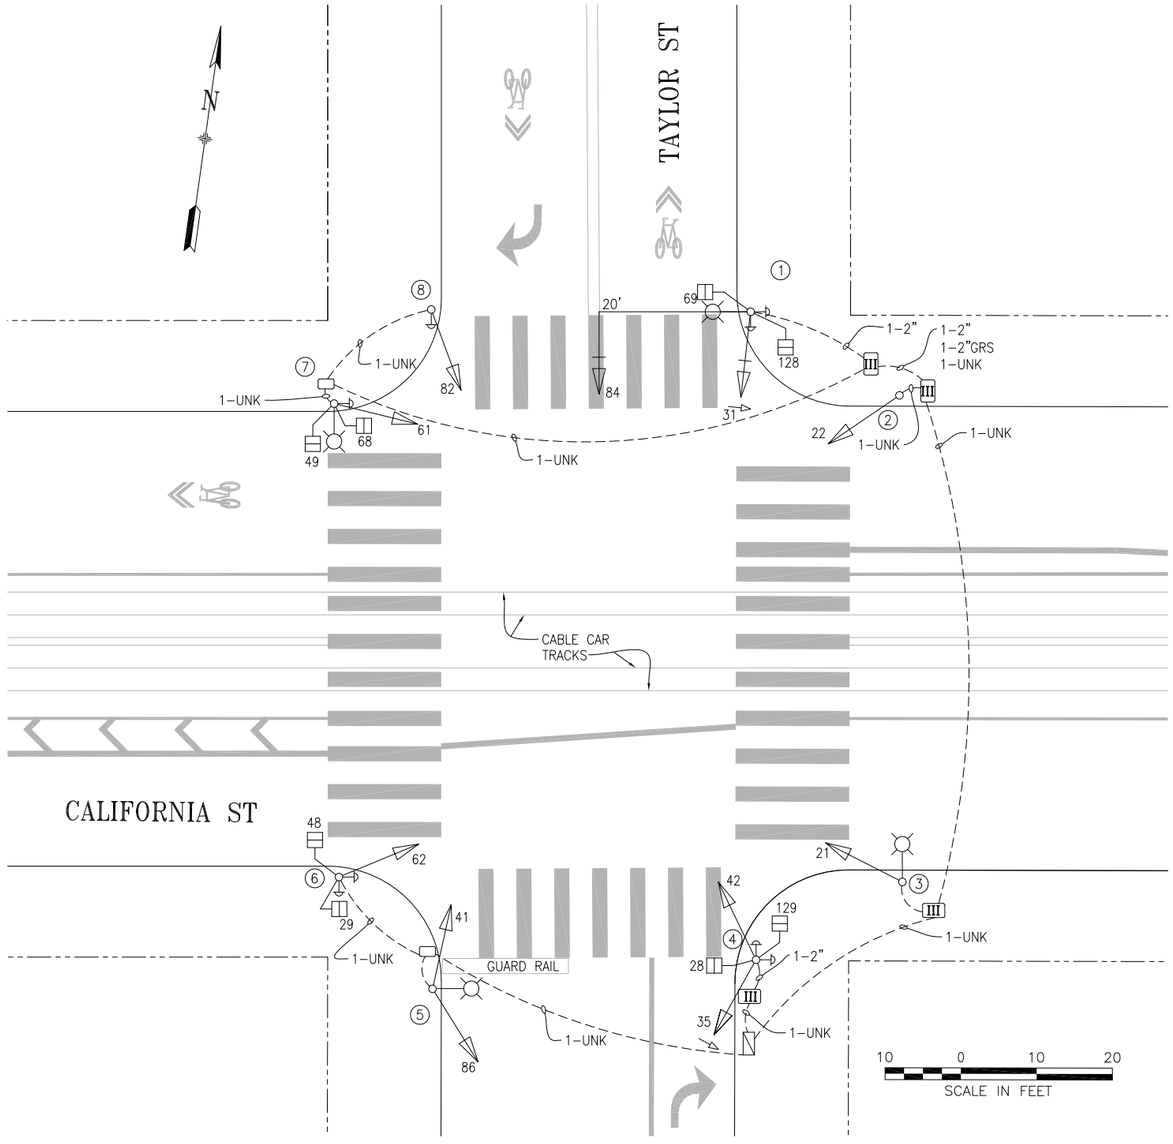

POLE AND EQUIPMENT SCHEDULE

POLE No.	TYPE OF POLE	LUMINAIRE VOLTAGE/ WATTAGE	VEHICLE SIGNAL No.	VEHICLE SIGNAL TYPE	VEHICLE SIGNAL MOUNTING	VISORS	PEDESTRIAN SIGNAL No.	PEDESTRIAN SIGNAL TYPE	PEDESTRIAN SIGNAL MOUNTING	REMARKS
1	17-2-100 WITH 20' MAST ARM & 6' LUMINARE ARM		31 84	3S12"RA 3S12"GSA	SV-1-T MAS	T T	69 128	1S-COUNT 1S-COUNT	SP-1-SF(12") SP-1 (22")	SIGNAL 31 MOUNT AT 19FT (ABOVE HANDHOLE) BACKPLATE BACKPLATE APS-4W APS-4W
2	PEDESTAL SIGNAL POLE (10')		22	3S12"	TV-1-T					
3	SL W/ 6' LA		21	3S12"	SV-1-T					
4	1-A (10')		42 35	3S12"FY 3S12"RA	TV-2-T		28 129	1S-COUNT 1S-COUNT	SP-1-SF (12") SP-1 (22")	APS-4W APS-4W
5	SL W/ 6' LA		41 86	3S12"FY 3S12"	SV-2-TA					
6	PEDESTAL SIGNAL POLE (10')		62	3S12"	TV-1-T		29 48	1S-COUNT 1S-COUNT	SP-1 (22") SP-1-SF (12")	APS-4W APS-4W
7	SL W/ 6' LA		61	3S12"	SV-1-T		49 68	1S-COUNT 1S-COUNT	SP-1-SF (12") SP-1 (22")	APS-4W
8	PEDESTAL SIGNAL POLE (10')		82	3S12"	TV-1-T					APS-4W

NOTE: APS BUTTONS INSTALLED 8/3/2020.

NO.	DATE	DESCRIPTION	BY	APP.
0	6/24/19	UPGRADE BY 2823J, CONVERTED FROM CT PLANS & PER FIELD	DYeung	GdeLeon

TABLE OF REVISIONS
CHECK WITH TRACING TO SEE IF YOU HAVE LATEST REVISION

REFERENCE INFORMATION & FILE NO. OF SURVEYS

SAN FRANCISCO MUNICIPAL TRANSPORTATION AGENCY
CITY AND COUNTY OF SAN FRANCISCO

DRAWN: DYeung DATE: 4/2020
CHECKED: GdeLeon DATE: 4/2020

SCALE: AS SHOWN
SHEET OF SHEETS: 1 OF 1

TRAFFIC SIGNAL INVENTORY DIAGRAM
CALIFORNIA STREET AND TAYLOR STREET

CNN NO. 25088000
REV NO. 0