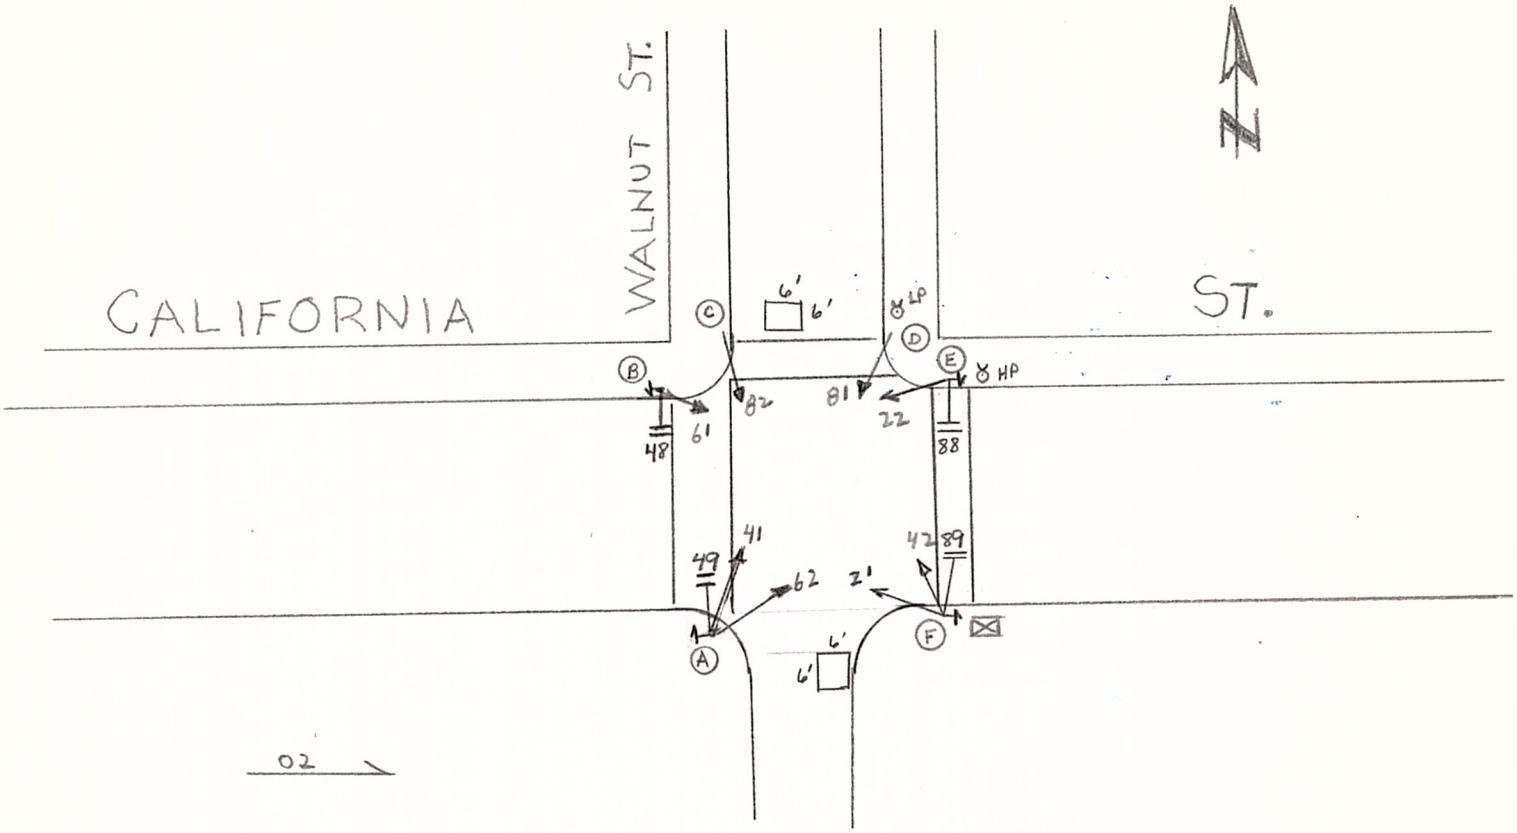

7-1-15

POLE	FUNC.	MAT'L	SIGNAL NO.	MAKE	NO. OF SECT.	SIZE	VISOR	B.P. OR LOUVERS	MOUN'T	PED SIGNAL NO.	LEGEND	MESSAGE ELEMENT	MESSAGE COLOR	MAKE	MOUN'T
A	S	S	41	EC	3	12"	T	No	T	48	I	1S-1	OR/W	ICC	S
B	L	S	62	EC	3	12"	T	No	T	49	I	1S-1	OR/W	ICC	S
C	S	S	61	EC	3	12"	T	No	S	88	I	1S-1	OR/W	ICC	S
D	S	S	82	EC	3	12"	T	No	T	89	I	1S-1	OR/W	ICC	S
E	S	S	81	EC	3	12"	T	No	T						
F	L	S	22	EC	3	12"	T	No	T						
			21	EC	3	12"	T	No	S						
			42	EC	3	12"	T	No	S						

CONTROLLER CABINET SIZE : ORDINARY BASE CABINET: yes

COMMENTS : CONTRACT 21
SRC# 2015-191: Replace 8" SIGNAL HEADS W/12", AND FC 8" VISOR W/ TUNNEL VISOR (6/10/2015)