TRAFFIC SIGNAL INVENTORY DIAGRAM

Intersection: CESAR CHAVEZ @ EVANS

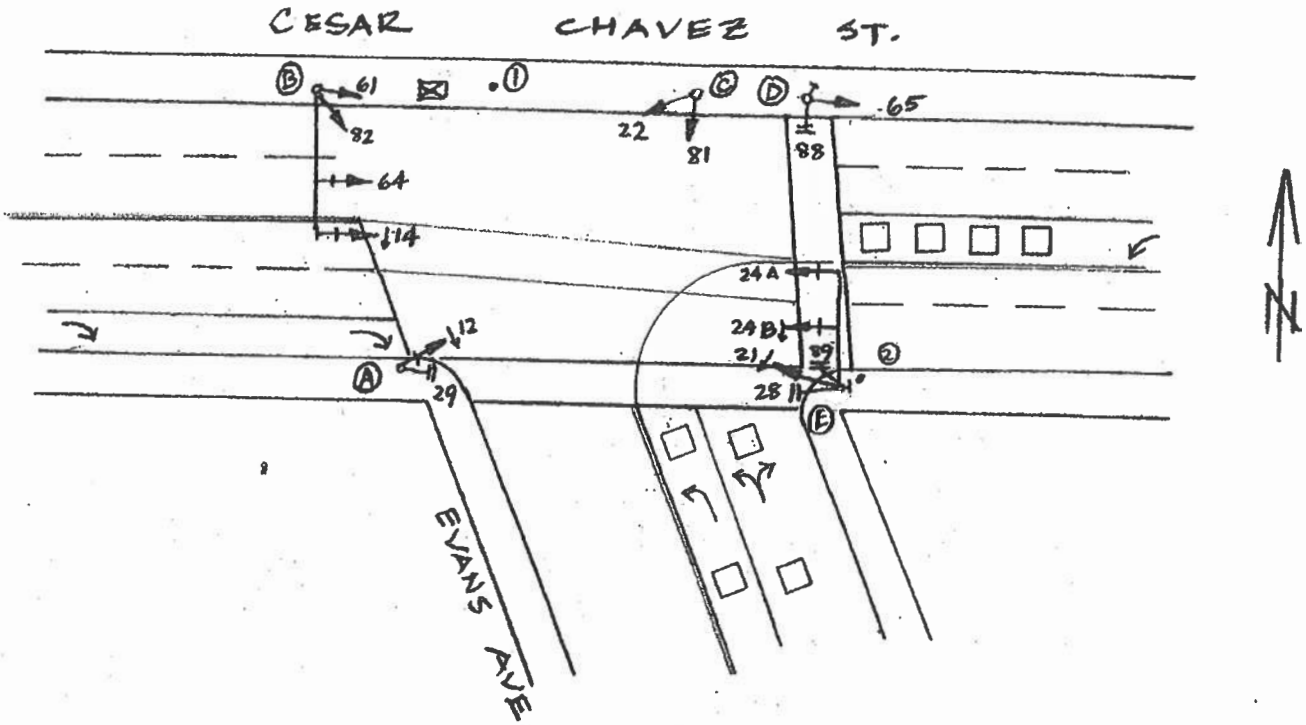

Prepared by: E. Chen

Date Prepared: 2/10/20

Pole	Func.	Matl	Veh. Sig. No.	Make	No. of Sect.	Size	Visor	BP / Louver	Mtg	Ped. Sig. No.	Legend	M'sge Element	M'sge Color	Make	Mtg
A	U	W	21	CH	5	12" RYG + YG(RA)	FC	—	S	28	I	LED*	OR/W	ICC	S
B	S	S	22	EA	3	8"	FC	—	T	29	I	LED*	OR/W	ICC	S
C	S	C	24A	CH	3	12"	FC	BP	MAS	88	I	LED*	OR/W	ICC	S
D	U	W	24B	CH	5	12" RYG + YG(RA)	FC	BP	MAS	89	I	LED*	OR/W	ICC	S
E	S	S	61		3	12" PV	FC	—	S						
			64		3	12" PV	CAP	BP	MAS						
			65		3	12" PV	FC	—	S						
			14	CH	3	12" LA	FC	BP	MAS						
1	U	W	12	TCT	3	12" LA	FC	—	S						
2	U	W	81	EA	3	8"	FC	—	T						
			82	EA	3	12"	FC	—	S						
										*	L.E.D. PED SIGNALS WITH COUNTDOWN FEATURE.				

Controller Cabinet Size: M CABINET **Base Cabinet:** NONE

Comments: Removed PPBs from Phase 2P per SRC 2019-350.