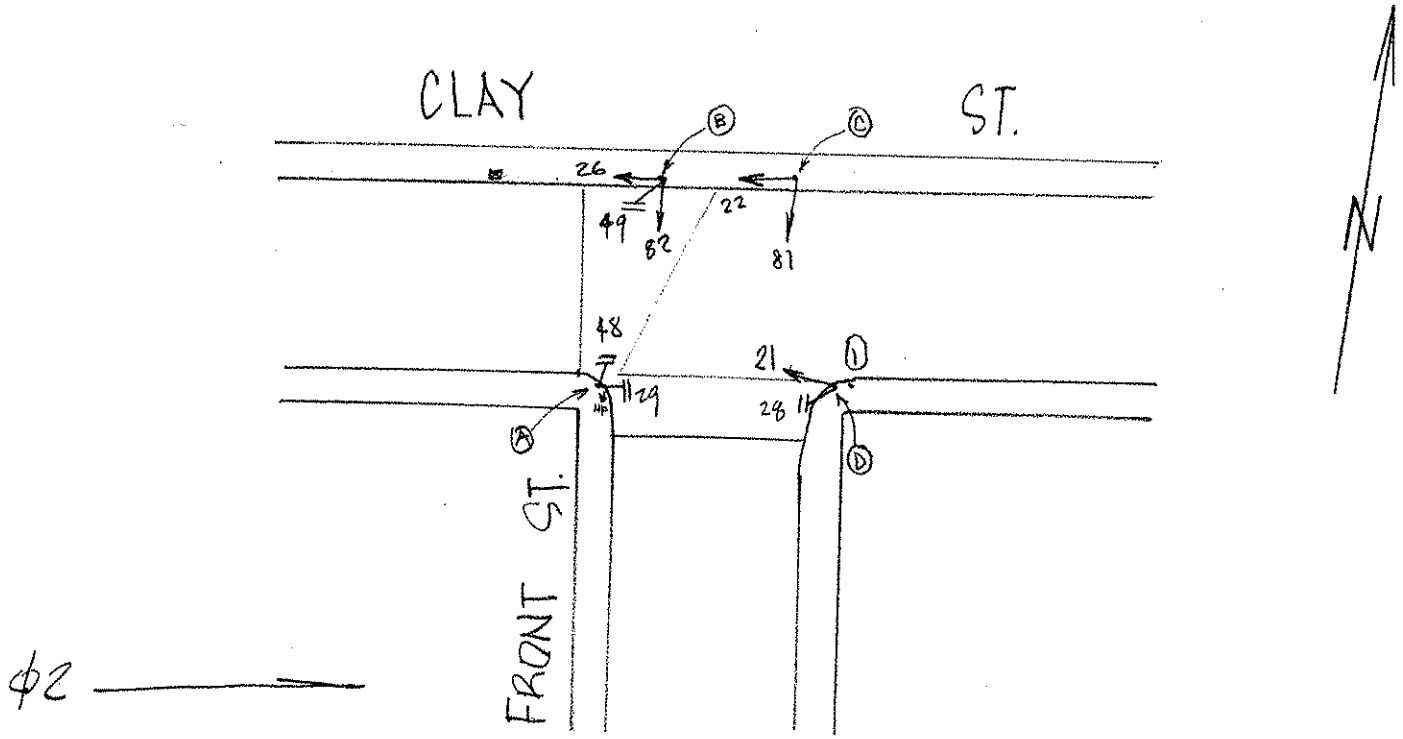

5-14-02

POLE	FUNC.	MAT'L
A	L	S
B	S	S
C	S	S
D	S	S
1	M	S

SIGNAL NO.	MAKE	NO. OF SECT.	SIZE	VISOR	B.P. OR LOUVERS	MOUN'T
P2	EC	3	8"	FC 8"	NO	T
22	EC	3	8"	FC 8"	NO	T
81	EC	3	8"	FC 8"	NO	T
21	GA	3	8"	FC 8"	NO	T
26	EC	3	8"	FC 8"	NO	T

PED SIGNAL NO.	LEGEND	MESSAGE ELEMENT	MESSAGE COLOR	MAKE	MOUN'T
29	W/DW	GRD	W/OR	ED	S
48	W/DW	GRD	W/OR	ED	S
49	W/DW	GRD	W/OR	ED	S
28	W/DW	GRD	W/OR	ED	S

CONTROLLER CABINET SIZE : ORDINARY BASE CABINET: YES

COMMENTS : ADDED SIGNAL 26