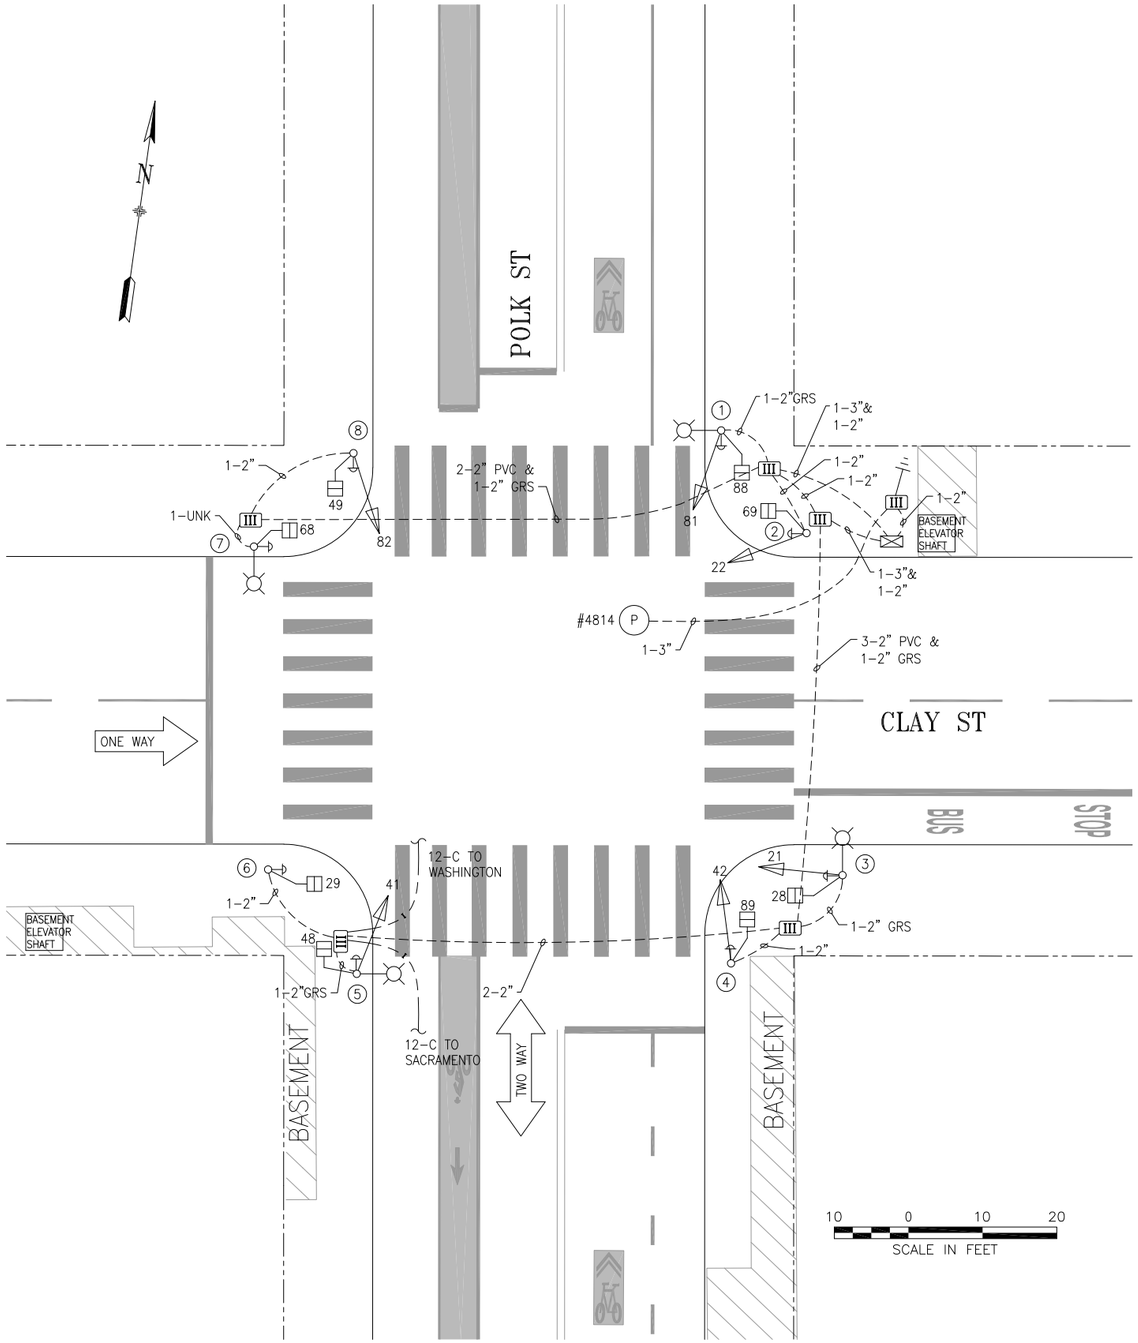

POLE AND EQUIPMENT SCHEDULE

POLE No.	TYPE OF POLE	LUMINAIRE VOLTAGE/ WATTAGE	VEHICLE SIGNAL					PEDESTRIAN SIGNAL			REMARKS
			No.	TYPE	MOUNTING	VISORS	LOUVERS	No.	TYPE	MOUNTING	
1	ORNAMENTAL STREET LIGHT		81	3S12"	SV-1-T	T		88	1S-COUNT	SP-1	APS-2W
2	1-A (10')		22	3S12"	TV-1-T	T		69	1S-COUNT	SP-1	APS-2W
3	CITY STANDARD STREET LIGHT		21	3S12"	SV-1-T	T		28	1S-COUNT	SP-1	APS-2W
4	1-A (10')		42	3S12"	TV-1-T	T		89	1S-COUNT	SP-1	APS-2W
5	ORNAMENTAL STREET LIGHT		41	3S12"	SV-1-T	T		48	1S-COUNT	SP-1	APS-2W
6	1-A (7')							29	1S-COUNT	TP-1	APS-2W
7	CITY STANDARD STREET LIGHT							68	1S-COUNT	SP-1	APS-2W
8	1-A (10')		82	3S12"	TV-1-T	T		49	1S-COUNT	SP-1	APS-2W

NO.	DATE	DESCRIPTION	BY	APP.
2	9/24/20	APS INSTALLED PER SRC 2019-186	JH	GD
1	6/4/19	2126J PUNCH LIST INSPECTION-POLES 1 & 5 REPLACED	JH	GD
0	7/13/17	FULL UPGRADE BY 2586J; CONVERTED FROM AS-BUILTS	JH	GD

TABLE OF REVISIONS
CHECK WITH TRACING TO SEE IF YOU HAVE LATEST REVISION

REFERENCE INFORMATION & FILE NO. OF SURVEYS

SAN FRANCISCO MUNICIPAL TRANSPORTATION AGENCY
CITY AND COUNTY OF SAN FRANCISCO

DRAWN: JH DATE: 4/2018
CHECKED: GD DATE: 4/2018

SCALE: AS SHOWN
SHEET OF SHEETS 01 OF 01

TRAFFIC SIGNAL INVENTORY DIAGRAM
CLAY STREET AND POLK STREET

CNN NO. 25302000
REV NO. 2