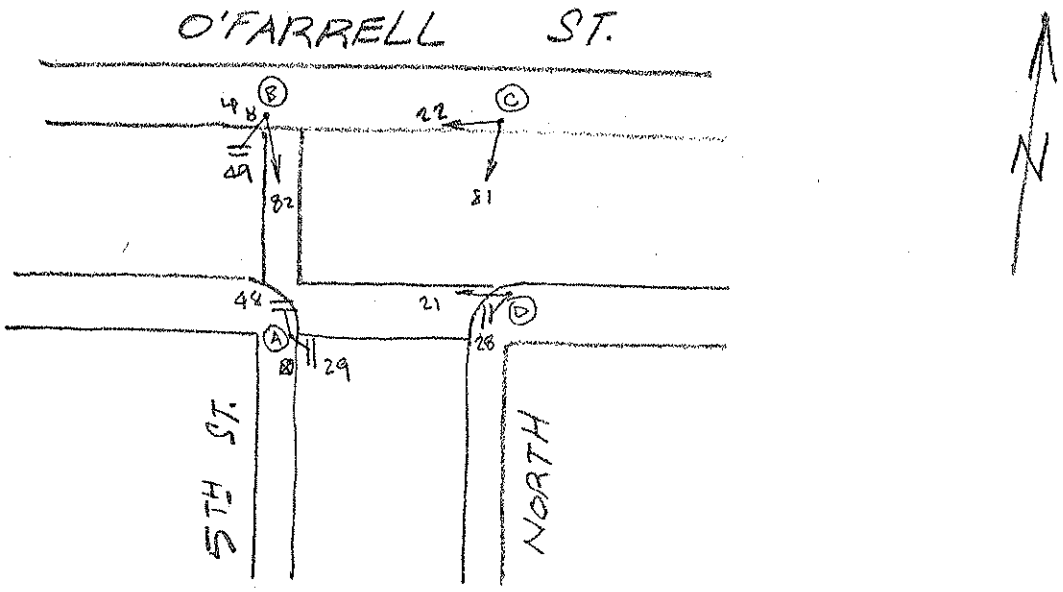

$\phi 2$ ——→

3-16-79

POLE	FUNC.	MAT'L
A	L	S
B	L	O
C	S	S
D	L	O

SIGNAL NO.	MAKE	NO. OF SECT.	SIZE	VISOR	B.P. OR LOUVERS	MOUN'T
82	EC	3	8" R+Y 12" G→	FC 8" FC 12"	NO	S
22	EC	3	8"	FC 8"	NO	T
81	EC	3	8" R+Y 12" G→	FC 8" CAP	NO	T
21	AUTO	3	8"	FC 8"	NO	S

PED SIGNAL NO.	LEGEND	MESSAGE ELEMENT	MESSAGE COLOR	MAKE	MOUN'T
29	W/DW	GRD	W/OR	ED	S
48	W/DW	GRD	W/OR	ED	S
49	W/DW	GRD	W/OR	ED	S
28	W/DW	GRD	W/OR	ED	S

CONTROLLER CABINET SIZE : ORDINARY BASE CABINET: YES

COMMENTS :