Davis St & Washington St

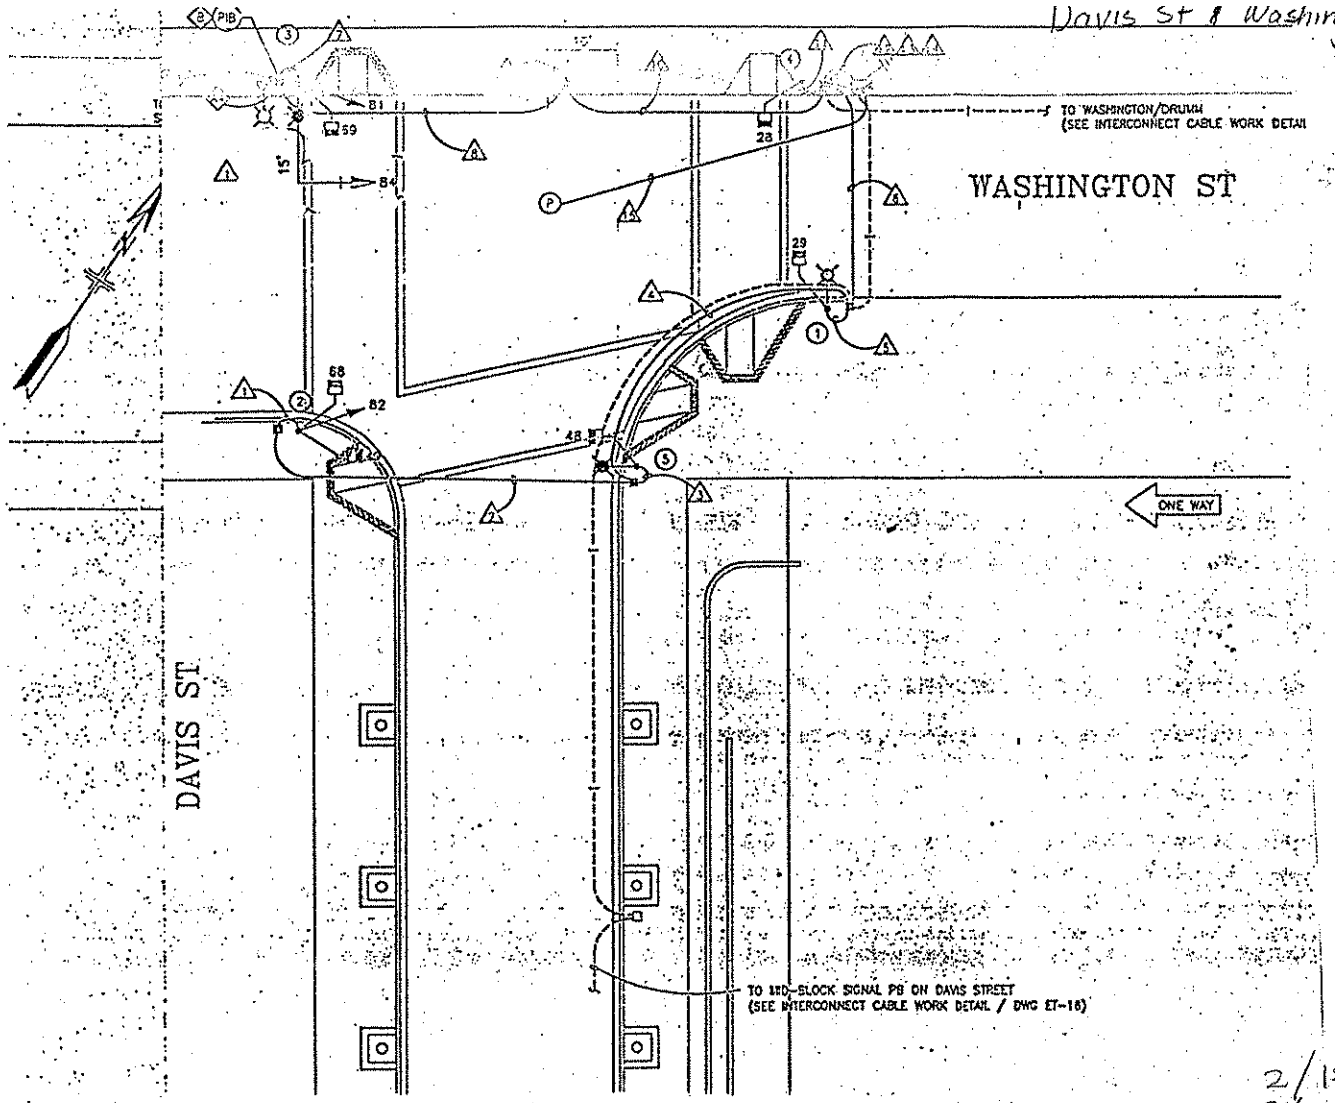

2/13/02
8/22/01

POLE	FUNC.	MAT'L
1	L	S
2	S	S
3	L	S
4	S	S
5	L	S

SIGNAL NO.	MAKE	NO. OF SECT.	SIZE	VISOR	B.P. OR LOUVERS	MOUN'T
82	TCT	3S	8' RYG	T	E	TV-1
84	TCT	3S	12' RYG	T	BP	MAG
81	TCT	3S	8' RYG	T	—	SV-1

PED SIGNAL NO.	LEGEND	MESSAGE ELEMENT	MESSAGE COLOR	MAKE	MOUN'
29	T	15-IN.	W/OR	K.C.	SP-1
68	T	15-IN	W/OR	ICC	SP-1
49	T	15-IN	W/OR	ICC	SP-1
69	T	15-IN	W/OR	ICC	SP-1
28	T	15-IN	W/OR	ICC	TP-1
48	T	15-IN	W/OR	ICC	SP-1

CONTROLLER CABINET SIZE : ~~M CAB~~ BASE CABINET: _____

COMMENTS :