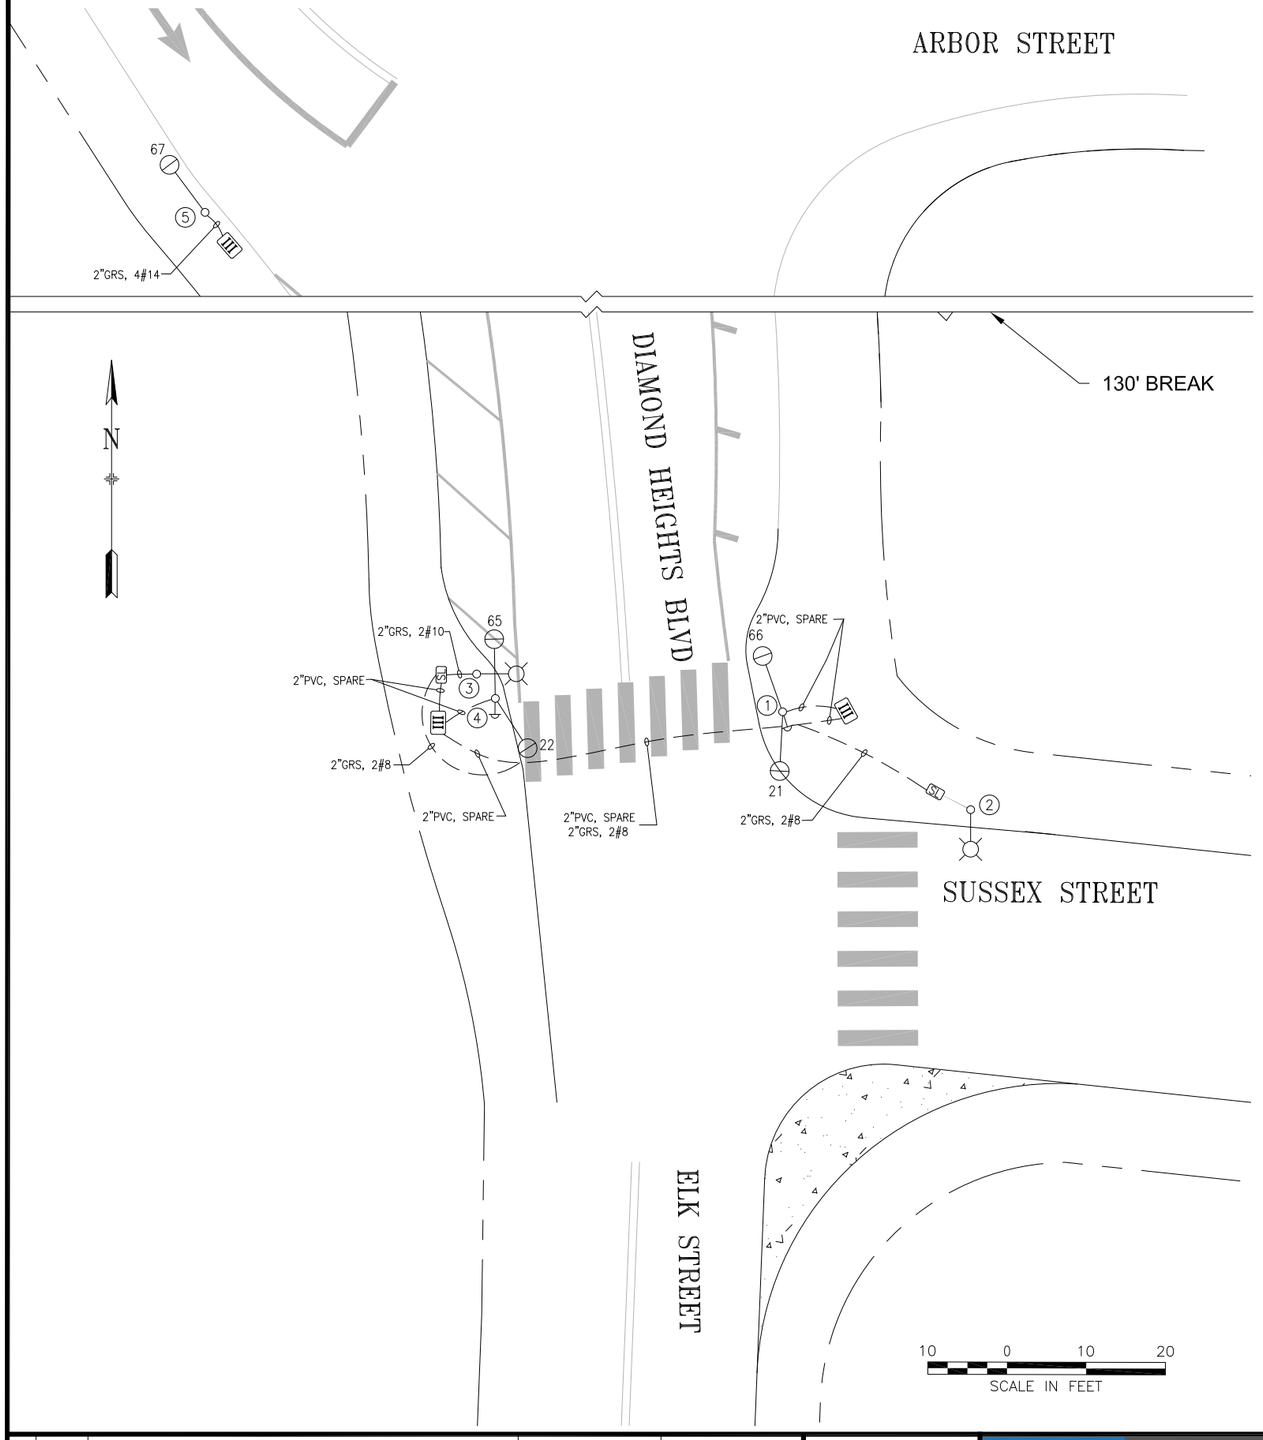

POLE AND EQUIPMENT SCHEDULE

POLE No.	TYPE OF POLE	VEHICLE SIGNAL					PEDESTRIAN SIGNAL				ITS DEVICE	REMARKS
		No.	TYPE	MOUNTING	VISORS	LOUVERS/BP	No.	TYPE	MOUNTING	BUTTON		
①	1–A(15')	21 66	RRFB RRFB	SIDE MOUNT SIDE MOUNT						PPB		SOLAR RRFB TRANSMITTER TOP MOUNTED
②	SL W/6' LUMINAIRE ARM											
③	SL W/6' LUMINAIRE ARM											
④	1–A(15')	22 65	RRFB RRFB	SIDE MOUNT SIDE MOUNT						RRFB		SOLAR RRFB TRANSMITTER TOP MOUNTED
⑤	1–A (15')	67	RRFB	SIDE MOUNT								SOLAR RRFB TRANSMITTER TOP MOUNTED

NO.	DATE	DESCRIPTION	BY	APPROVED
0	12/18/23	CONVERTED FROM CONTRACT 2996J	S.SHARIATI	S.ROBACK

TABLE OF REVISIONS
CHECKOUT DRAWING THROUGH THE SID CUSTODIAN FOR THE LATEST REVISION

SFMTA

DRAWN BY: SHAHRAM SHARAITI DATE: 09/13/23
CHECKED BY: SOROUSH ROBACK DATE: 12/18/23

AS SHOWN
SHEET OF SHEETS: 01 OF 01

TRAFFIC SIGNAL INVENTORY DIAGRAM

DIAMOND HEIGHTS BLVD, ELK ST, & SUSSEX ST

22278000
REV NO: 0