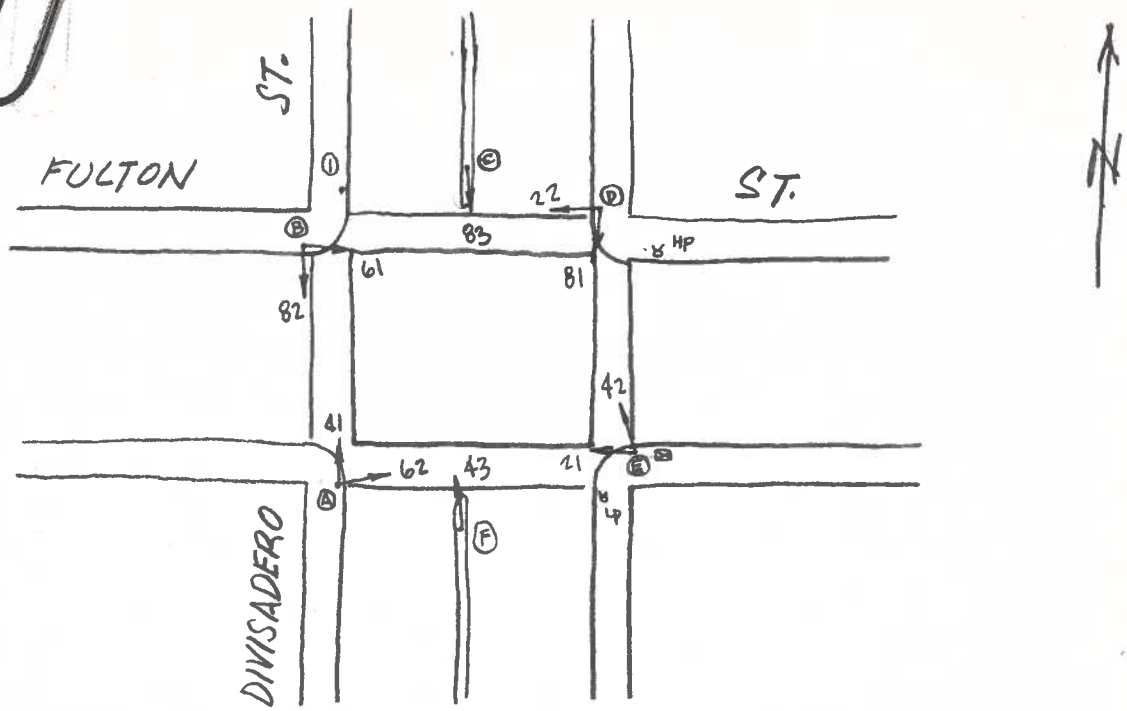

#2 ——

10-14-19

POLE	FUNC.	MAT'L
A	S	C
B	L	C
C	L	C
D	S	C
E	L	C
F	L	C
1	M	S

SIGNAL NO.	MAKE	NO. OF SECT.	SIZE	VISOR	B.P. OR LOUVERS	MOUN'T
41	EC	3	12"	T	No	T
62	EC	3	12"	T	No	T
82	EC	3	12"	T	No	S
61	EC	3	12"	T	No	S
83	EC	3	12"	T	No	S
22	GA	3	12"	T	NO	T
81	GA	3	12"	T	B.P.	T
42	EC	3	12"	T	NO	S
21	EC	3	12"	T	NO	S
43	EC	3	12"	T	NO	S

PED SIGNAL NO.	LEGEND	MESSAGE ELEMENT	MESSAGE COLOR	MAKE	MOUN'T

CONTROLLER CABINET SIZE : ORDINARY BASE CABINET: YES

COMMENTS :

Shahram Shariati

SRC 2019-127 - Upgrade All 8" Signal Heads to 12" Heads