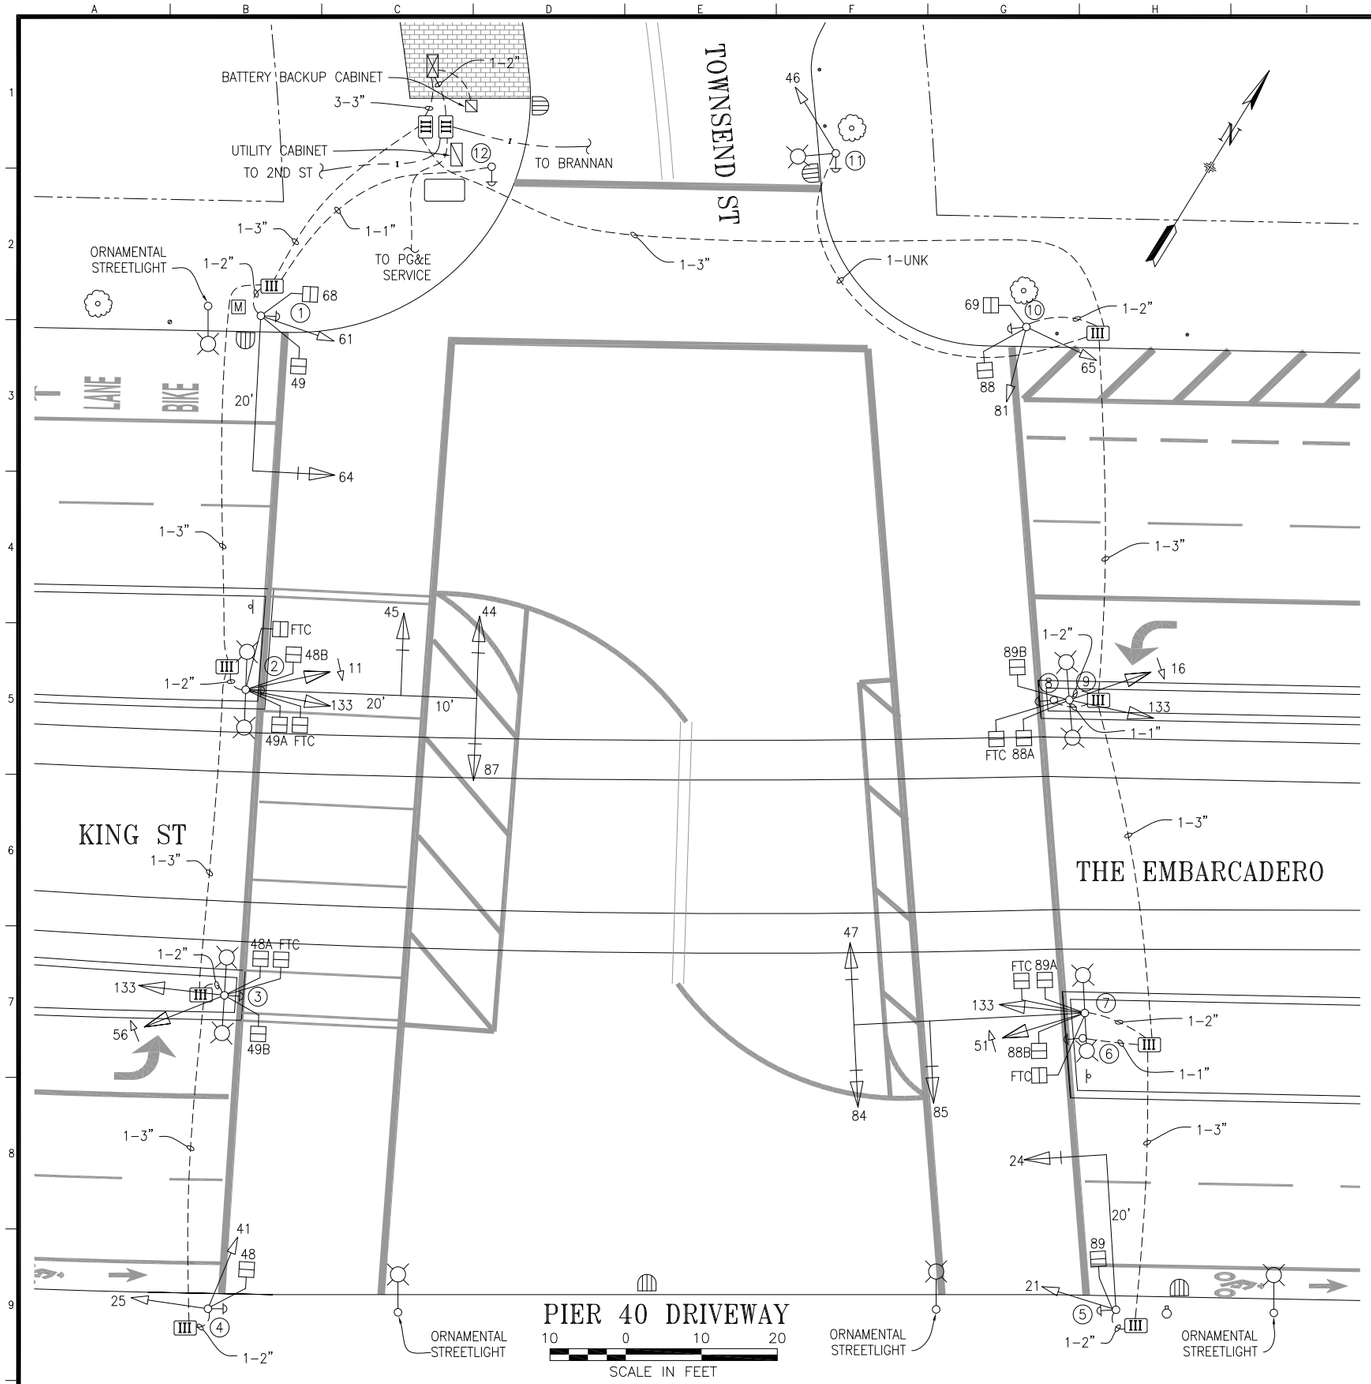

POLE AND EQUIPMENT SCHEDULE

POLE No.	TYPE OF POLE	LUMINAIRE VOLTAGE/ WATTAGE	VEHICLE SIGNAL No.	VEHICLE SIGNAL TYPE	VEHICLE SIGNAL MOUNTING	VEHICLE SIGNAL VISORS	VEHICLE SIGNAL LOUVERS/BP	PEDESTRIAN SIGNAL No.	PEDESTRIAN SIGNAL TYPE	PEDESTRIAN SIGNAL MOUNTING	REMARKS
1	16-1-70 W/ 20' MAST ARM		61 64	3S8" 3S12"	SV-1 MAS	FC FC	 BP	49 68	IS-COUNT IS-COUNT	SP-2	61 MOUNTED AT 12' APS
2	MUNI POLE W/ 30' MAST ARM AND DUAL LA		11 44 45 87 133	3S12"FYLA 3S12" 3S12" 3S12"FY 2S12"LB	SV-1 MAS MAS MAS SV-1	FC FC FC FC T	 BP BP BP 	48B 49A FTC FTC	IS-COUNT IS-COUNT IS 16"x16" IS 24"x24"	SP-3 SP-1	MOUNT 11 180° FROM TRACK SIDE OF POLE AND AT 8' APS
3	MUNI POLE W/ DUAL LUMINAIRE ARMS		56 133	3S12"LA 2S12"LB	SV-1 SV-1	FC T		48A 49B FTC	IS-COUNT IS-COUNT IS 16"x16"	SP-3	56 MOUNTED AT 4'6" APS
4	1-A (12')		25 41	3S8" 3S8"	TV-2-T	FC FC	 LOUVERS	48	1S-COUNT	SP-1	APS
5	16-1-70 W/ 20' MAST ARM		21 24	3S8" 3S12"	SV-1 MAS	FC FC	 BP	89 68	IS-COUNT IS-COUNT	SP-2	21 MOUNTED AT 12' APS
6	PPB POLE										APS
7	MUNI POLE W/ 30' MAST ARM AND DUAL LA		51 47 84 85 133	3S12"LA 3S12" 3S12"FY 3S12"FY 2S12"LB	SV-1 MAS MAS MAS SV-1	FC FC FC FC T	 BP BP BP BP	88B 89A FTC FTC	IS-COUNT IS-COUNT IS 16"x16" IS 24"x24"	SP-3 SP-1	MOUNT 51 180° FROM TRACK SIDE OF POLE AND AT 8'
8	PPB POLE										APS
9	MUNI POLE W/ DUAL LUMINAIRE ARMS		16 133	3S12"FYLA 2S12"LB	SV-1 SV-1	FC FC	 BP	88A 89B FTC	IS-COUNT IS-COUNT IS 16"x16"	SP-3	16 MOUNTED AT 4'6" PPB
10	1-A (12')		65 81	3S8" 3S8"FY	TV-2-T	FC FC	 LOUVERS	69	1S-COUNT	SP-1	APS
11	CITY STANDARD STREET LIGHT		46	3S8"	SV-1-T	FC					APS
12	PPB POLE										APS

NO.	DATE	DESCRIPTION	BY	APP.
4	9/19/20	SRC 2019-288: INSTALLED 24"X24" FTC ON POLES 2 & 7	CXL	CL
3	12/11/16	RELOCATE AND RELABEL TRANSIT SIGNALS PER SRC 2016-318	AL	MV
2	6/2/15	ADD PPB POLE 12 PER 2142J AS-BUILTS; APS PER SRC 2014-298	JH	GD
1	7/27/14	MUNI SIGNALS PER SRC 2014-122	BW	CW
0	4/19/97	SIGNAL UPGRADED; CONVERTED FROM 6658E AS-BUILTS	JH	GD

TABLE OF REVISIONS
CHECK WITH TRACING TO SEE IF YOU HAVE LATEST REVISION

REFERENCE INFORMATION & FILE NO. OF SURVEYS

SAN FRANCISCO MUNICIPAL TRANSPORTATION AGENCY
CITY AND COUNTY OF SAN FRANCISCO

DRAWN: JH DATE: 8/2017
CHECKED: GD DATE: 8/2017

SCALE: AS SHOWN
SHEET OF SHEETS: 1 OF 1

TRAFFIC SIGNAL INVENTORY DIAGRAM
THE EMBARCADERO, KING STREET, PIER 40, AND TOWNSEND STREET

CNN NO. 23592000
REV NO. 4