


SHEET NOTES:

- 1 COORDINATE WITH PG&E AND INFORM SFPUC TO DISCONNECT EXISTING TRAFFIC SIGNAL SERVICE AFTER ACTIVATION OF NEW INTERSECTION SIGNALS, PROVIDE 45 DAYS NOTICE, PRIOR TO DISCONNECTING EXISTING SERVICE, CONTRACTOR TO FIELD VERIFY AND MAINTAIN EXISTING CIRCUITS
- 2 CITY FORCES TO INSTALL CITY FURNISHED APS BUTTONS ON POLES AS SHOWN ON INTERSECTION DRAWING AND AS INDICATED IN POLE & EQUIPMENT SCHEDULE. CONTRACTOR TO INSTALL APS WIRING AS INDICATED IN CONDUIT AND WIRING SCHEDULE.
- 3 STRIPING TO BE INSTALLED BY CITY FORCES
- 4 CITY FORCES TO FURNISH 2070 CONTROLLER AND 352i-ATC CABINET FOR CONTRACTOR TO INSTALL. FOUNDATION PER CALTRANS TYPE 332 WITH MODIFIED 17"x16" CONDUIT OPENING
- 5 ABANDON EXISTING CONDUIT AND WIRING, CUT EXISTING CONDUIT AND WIRING TO PULL BOX WALL AND CAP ENDS. PRIOR TO ABANDONING CONDUIT, WIRING AND PULLBOXES, CONTRACTOR TO FIELD VERIFY IF THERE ARE ANY EXISTING CIRCUIT TO BE MAINTAINED
- 6 REFER TO STREETLIGHT ELECTRICAL DRAWINGS FOR SERVICE CONNECTION, FIXTURE TYPE AND CONDUIT ROUTING
- 7 R/C STREETLIGHT AND TRAFFIC SIGNAL POLES AND FOUNDATION, U.O.N DURING POLE LAYOUT, RESTORE CURB RAMP
- 8 INSTALL CITY FURNISHED ONE SECTION LED PEDESTRIAN SIGNAL MODULE IN CONTRACTOR FURNISHED ONE SECTION PEDESTRIAN SIGNAL HOUSING
- 9 PROVIDE 40A FUSE FOR TRAFFIC SIGNAL SERVICE AND 40A FUSE FOR STREET LIGHT SERVICE, PROVIDE LABELING
- 10 REFER TO PG&E CONSTRUCTION SKETCH FOR EXACT LOCATION OF THE PG&E SERVICE, COORDINATE WITH PG&E AND INFORM SFPUC FOR SERVICE ACTIVATION
- 11 NOT USED
- 12 PROVIDE NEW WIRES OR CONTRACTOR HAS THE OPTION TO PULL BACK EXISTING WIRES FOR THE INTERCONNECT FROM THE EXISTING CONTROLLER AND PULL THROUGH THE NEW INTERCONNECT CONDUIT TO THE NEW CONTROLLER

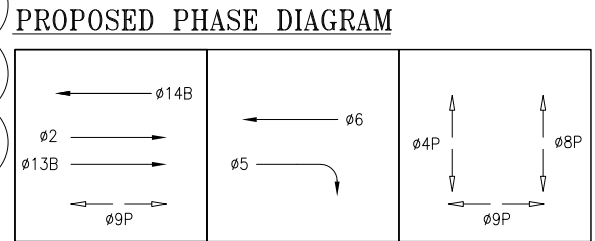

NOTE;
THIS AUTOCAD DRAWING HAS BEEN REVISED AND REPLOTTED
SUBSEQUENT TO INTERNAL ENGINEERING APPROVAL AND
SIGN-OFF. FOR THOSE SIGNATURES, SEE THE DRAWING
PLOTTED AND ISSUED PREVIOUSLY DURING BIDDING. THE
SIGNED DRAWING REMAINS VALID EXCEPT FOR THE CHANGES
ONLY AS CLEARLY MARKED ON THIS DRAWING AND ISSUED
UNDER THIS LATEST REVISION NUMBER AS SHOWN IN THE
TABLE OF REVISIONS LOCATED AT THE LOWER LEFT CORNER
OF THE DRAWING. ALL ISSUED REVISIONS SUBSEQUENT TO
PREVIOUSLY PLOTTED DRAWING DURING BIDDING REMAIN
VALID UNLESS SUPERSEDED BY LATER ISSUED REVISIONS.
CHECK ALL ISSUED REVISIONS OF THIS DRAWING.

1	1/28/20	RELOCATE CONTROLLER CABINET REVERSE PHASE NUM	GW/GL	CH/SL	
NO.	DATE	DESCRIPTION	BY	APP.	
TABLE OF REVISIONS					
THIS DRAWING WAS LAST MODIFIED: 01/28/20 10:06, BY: gwing					

REFERENCE INFORMATION & FILE NO. OF SURVEYS



DESIGN &
ENGINEERING
PUBLIC WORKS
CITY & COUNTY OF SAN FRANCISCO
30 VAN NESS AVENUE, 5TH FLOOR
SAN FRANCISCO, CA 94102 - 6028

	Date:
Section Mgr:	
Deputy Division Mgr:	
Division Mgr: PATRICK RIVERA	

DESIGNED:	DATE:
SW/CMF	1/2017
DRAWN:	DATE:
SW/CMF	1/2017
CHECKED:	DATE:
CH/SL	7/2017

SCALE:
1" = 10'

SHEET OF SHEETS
OF

FOLSOM STREETSCAPE
IMPROVEMENT PROJECT

ESSEX STREET AND FOLSOM STREET TRAFFIC SIGNAL WORK

CONTRACT NO.	2148J
DRAWING NO.	ET-2.0
FILE NO.	109,841
REV. NO.	1

CONDUIT AND WIRING SCHEDULE (FURNISH AND INSTALL CONDUIT AND WIRES)

CONDUIT RUN NUMBER	1	2A	2B	3	4	5	6	7	8	9	10	11	12	13	14A	14B	15	16	17	18	19	20	
--------------------	---	----	----	---	---	---	---	---	---	---	----	----	----	----	-----	-----	----	----	----	----	----	----	--	--	