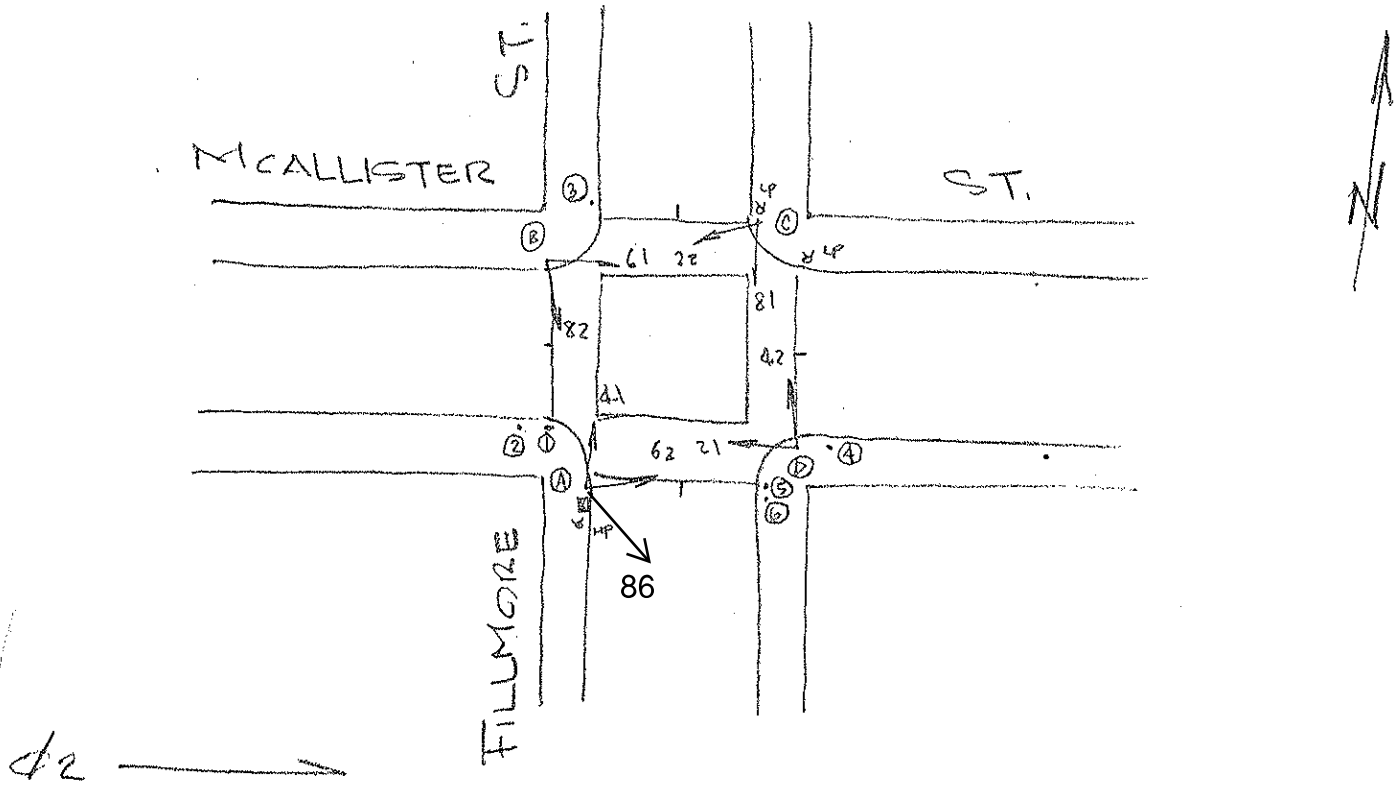

12/21/2022

POLE	FUNC.	MAT'L
A	M	S
B	L	C
C	S	C
D	M	S
1	U	W
2	M	S
3	U	S
4	M	S
5	M	S
6	U	W

SIGNAL NO.	MAKE	NO. OF SECT.	SIZE	VISOR	B.P. OR LOUVERS	MOUN'T
62	GA	3	12"	T 12"	No	S
41	GO	3	12"	T 12"	No	S
82	EA	3	12"	T 12"	No	S
61	EA	3	12"	T 12"	No	S
22	EA	3	12"	T 12"	No	T
81	EA	3	12"	T 12"	No	T
42	EA	3	12"	T 12"	No	S
21	EA	3	12"	T 12"	No	S
86*		3	12"	T 12"	NO	S

PED SIGNAL NO.	LEGEND	MESSAGE ELEMENT	MESSAGE COLOR	MAKE	MOUN'T

CONTROLLER CABINET SIZE : ORDINARY BASE CABINET: YES

COMMENTS : *86 mounted at 15'

Per SRC WO 2022-289: Updated 21 and 42 to 12" per field. Upgraded remaining signals to 12". Added signal 86 at 15' mounting height. Changed all visors to T 12".