POST & FILLMORE

06-07-2019

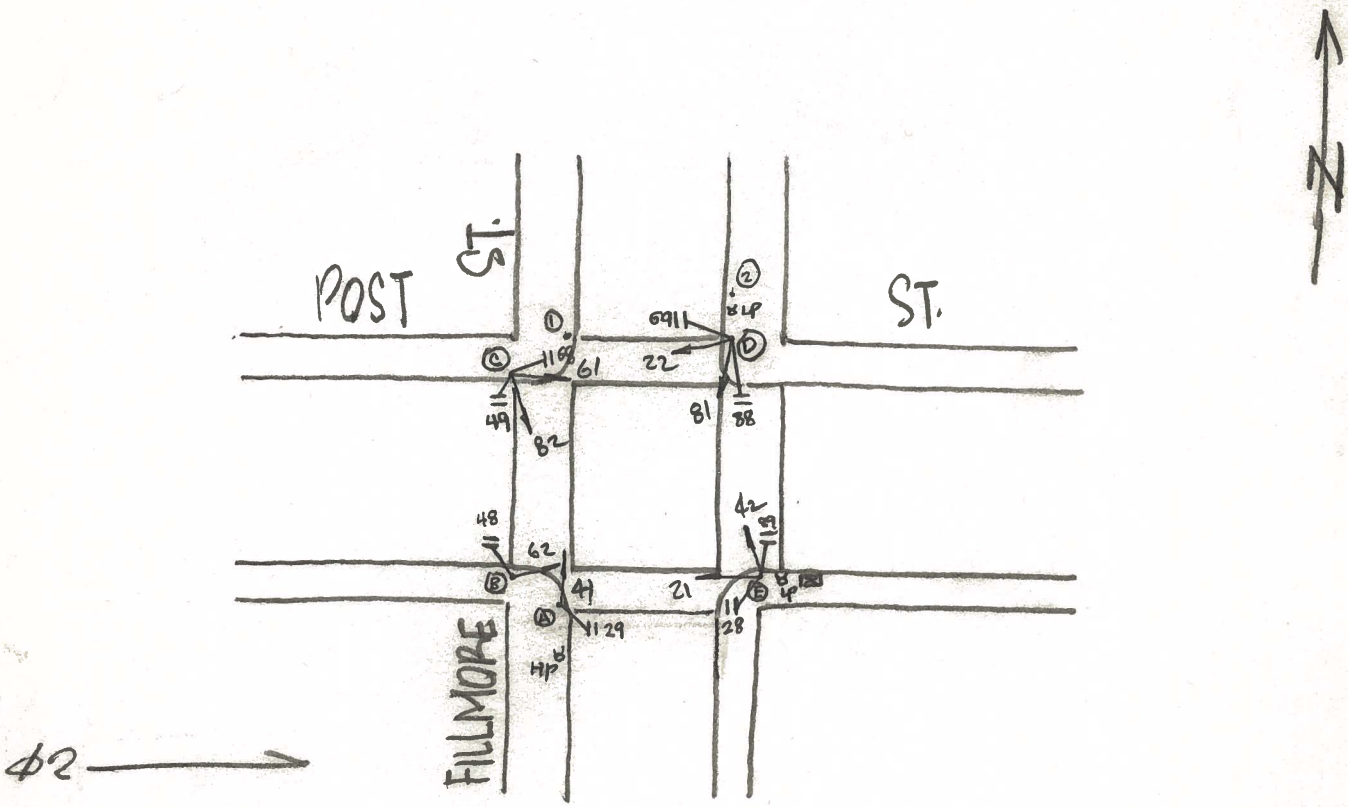


| POLE | FUNC. | MAT'L |
|---|---|---|
| A | L | S |
| B | S | S |
| C | L | C |
| D | S | C |
| E | L | C |
| 1 | M | S |
| 2 | M | S |

| SIGNAL NO. | MAKE | NO. OF SECT. | SIZE | VISOR | B.P. OR LOUVERS | MOUN'T |
|---|---|---|---|---|---|---|
| 41 | EC | 3 | 12" | T 12" | B.P. | S |
| 62 | EC | 3 | 12" | T 12" | NO | T |
| 82 | EC | 3 | 12" | T 12" | NO | S |
| 61 | EC | 3 | 12" | T 12" | NO | S |
| 22 | EC | 3 | 12" | T 12" | NO | T |
| 81 | EC | 3 | 12" | T 12" | NO | T |
| 42 | GA | 3 | 12" | T 12" | NO | S |
| 21 | GA | 3 | 12" | T 12" | NO | S |

| PED SIGNAL NO. | LEGEND | MESSAGE ELEMENT | MESSAGE COLOR | MAKE | MOUN'T |
|---|---|---|---|---|---|
| 28 | I | LED | W/OR | | S |
| 29 | I | LED | W/OR | | S |
| 48 | I | LED | W/OR | | S |
| 49 | I | LED | W/OR | | S |
| 68 | I | LED | W/OR | | S |
| 69 | I | LED | W/OR | | S |
| 88 | I | LED | W/OR | | S |
| 89 | I | LED | W/OR | | S |

CONTROLLER CABINET SIZE : ORDINARY BASE CABINET: NO

COMMENTS :

PER SRC 2018-413, UPGRADE ALL EXISTING 3S8" TO 3S12".

A.UY 06-07-2019